Sunflower County: Permit#: <u>GW 40554</u> Irrigation Equipment Date drilling completed: 8-4-05

State Well Report

Part 1

Mississippi Department of Environmental Quality Office of Land and Water Resources P.O. Box 10631 Jackson, MS 39289-0631 (601)961-5210 (601)354-6938 (fax)

For Office Use Only:
Aquifer:
Well #: F-/27
L. S. Elevation:
E-log#:

State Law requires that this report be prepared by the driller in detail and filed with the Department within


30 days of completion of drilling of the well.	without the devoted the same of the same o	
Well Owner Information	Well Location	
Owner Name Haney Farms	Latitude:°' Longitude:°'	
Mailing Address: 204 Jack Curry Road	Method of Lat/Long (circle one): Conventional Survey,	
	USGS quad, Hand-held GPS, Survey-grade GPS	
Ruleville, MS 38771	NW 1/4 NW 1/4 Sec 27 Twn 22N Rng 3W	
City State Zip Code	NE Distance Direction Nearest Town	
662-756-2847 Telephone No. ()	3 Miles NE of Ruleville	
Well 1	Data	
Purpose of Well (circle one) Home Industrial Public Supply	rfigation Fish Culture Other Replacement	
Date well drilling started: 8-4-05 Date w	· · · · · · · · · · · · · · · · · · ·	
If flowing, method of flow regulation: Valve Other (d	escribe)	
Static Water Level: 39 feet above on felow (circle one) i	and surface Date measured: 8-4-05	
Method of Measurement (circle one) feel tape electric tape	air line other:	
Hole depth: 116' Well depth: 116'	Well grouted to a depth offeet	
Type of grout (circle one): Cement Bentonite Mix		
Casing length: 76 feet Casing diameter: 16	inches Type of casing:PVC Sch. 40	
Screen length: 40 feet Screen diameter: 16	inches Type of screen: PVC Sch. 40	
Screen slot size:inches Setting depth: From	77feet_to116feet	
Type of completion (circle all applicable): Gravel packed Under	reamed Telescoped Open hole Natural Development	
Other (describe):		
Top of lap pipe or reduction in casing:feet. If telescoped or more than one screen, describe on back of page		
Logs run (circle all applicable): No log run Electric Gamma Ray Density Sonic Neutron Other:		
Name of organization running log(s):		
I certify that the well was drilled, constructed, and completed in accordance with all applicable requirements of the Mississippi		
Department of Environmental Quality and/or the Mississippi Dep	partment of Hofith regulations and state laws.	
Irrigation Equipment Inc. Patrick M. Chism 0695	Patrick M Chan	
Print Name of Water Well Contractor and License No.	Signature of Water Well Contractor	

Owner contracted with Peacock Pump & Repair (Cleveland, MS). Peacock Pump & Repair will install pump.

Ground Level

Description of Formations Encountered	From	То
	0	18
Clay Fine Sand	19	35
Fine Sand/gravel	36 56	55
Fine Sand/gravel Med. Sand/gravel	56	1116
	<u> </u>	
	<u> </u>	
	<u> </u>	
	<u></u>	
	1	
		$oldsymbol{ol}}}}}}}}}}}}}}}}}$
	1	
	·	
	T	
	T	
		T
	T	1
	1	

If more than one screen, show location of each on sketch

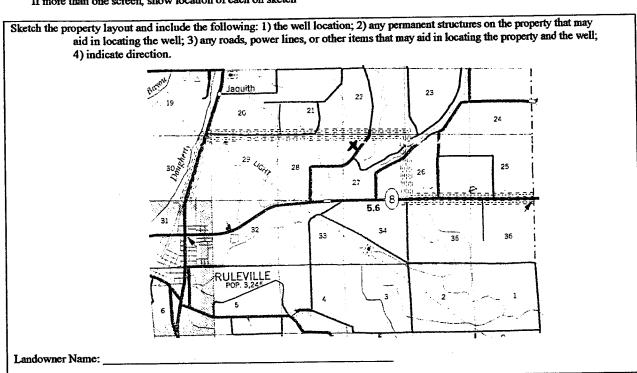

Patril M Chis

STATE WELL REPORT

Part 2

Sunflower

County: _ Permit #: Pump Installer's Completion Report
Mississippi Department of Environmental Quality
Office of Land and Water Resources

For Office Use Only:		
Aquifer:		
Well #: F-/27	_	
Elevation:	_	

Date completed	Jackson, MS 39289-0631 Well #: F-/27 (601)961-5210	
Date completed: (601)354-6938 (fax) Elevation: This report should be prepared by the pump installer in detail and filed with the Department within 30 days of the		
installation of pump. Well Owner Information Well Location		
Owner Name: Haney Farms		
	Latitude:Longitude:	
Mailing Address: 204 Jack Curry Road	Method of Lat/Long (circle one): Conventional Survey,	
	USGS quad, Hand-held GPS, Survey-grade GPS	
Ruleville, MS 38771 City State Zip Code		
112 - 1 20:17	Distance Direction Nearest Town	
Telephone No. (662) 756 - 2847	3MilesNEofRuleville	
Pum p Type Circle one	Power Type Circle one	
Air Lift Jet Submersible	Diesel Engine Gasoline Engine Natural Gas	
Bucket Piston Turbine	Electric Motor Hand Tractor PTO	
Centrifugal Rotary Flowing Well	Windmill Other (specify):	
Other (specify):	Horse Power Rating of Motor:	
Date Pump Installed: 8-5-05	Setting Depth: SO feet	
Rated Pump Capacity: 2000 Gallons Per Minut	Number of Stages:	
Pump Test Data	Method of Measuring Water Level Circle one	
Date Well Tested:		
Static Water Level (A): 43 Feet Below Land Surface Pumping Water Level (B): Feet Below Land Surface	Other (specify):	
Drawdown [(B) – (A)]:Feet Below Land Surface		
Test Pumping Rate:Gallons Per Minut	e Well yieldedGPM with a drawdown of	
Duration of Pump Test (minimum 4 hours):hour	sfeet afterhours of pumping	
I HEREBY CERTIFY that the above statements are true to the best of my knowledge. Parcy K'5 Rung + Repair Inc. D-174P Print Name of Pump Installer and License No. (if applicable) Signature of Pump Installer		