Country Sunflower	State we	ell Report	Ran Office Hee Only	
County.		rt 1	For Office Use Only:	
Permit #: 6W 41108	Mississippi Department		Aquifer:	
Irrigation Equipment		d Water Resources x 10631	Well #: E-133	
Driller:		39289-0631	L. S. Elevation:	
Date drilling completed: $5-26-06$		61-5210		
	(601)354-	6938 (fax)	E-log #:	
State Law requires that this repo 30 days of completion of drilling		riller in detail and filed w	ith the Department within	
Well Owner Informa		Wel	Location	
Owner Name	Latitude: 33 . 46 . 14		"Longitude: 90, 28, 0	
Mailing Address: 3830 Hwy.49		Method of Lat/Long (circle or	e): Conventional Survey,	
		USGS quad, Hand-held	GPS, Survey-grade GPS	
		NW , NW SW San 24	GPS, Survey-grade GPS 13 _{Twn} 22N Rng 3W	
	MS 38771	/4 /4 OCC	Kug Kug	
City State	•	Distance Direction 6 Miles NE	Nearest Town of Ruleville	
Telephone No. 662-756-2831	· · · · · · · · · · · · · · · · · · ·		M NUTEATTE	
	Well Da			
Purpose of Well (circle one) Home Indu	ustrial Public Supply	rrigation Fish Culture	Other Ceplacemen	
Date well drilling started: $5-26-$	-06 Date we	Il drilling completed:	5-26-06	
If flowing, method of flow regulation: Valv	via Other (dea	ih-a`l		
Static Water Level: 48 feet abo	ove or below (circle one) lar	nd surface Date measured:	シーノ ノーリカ	
-				
Method of Measurement (circle one)	eel tape) electric tape			
Method of Measurement (circle one)	\smile	air line other:		
105	th: 125			
105	\smile	air line other:		
Hole depth: <u>125</u> Well dep Type of grout (circle one): Cement	th: 125	air line other: Well grouted to a depth of	10feet	
Hole depth: <u>125</u> Well dep Type of grout (circle one): Cement Casing length: <u>85</u> feet Casin	th: <u>125</u> Bentonite Mix	air line other: Well grouted to a depth of inches Type of casing:		
Hole depth: <u>125</u> Well dep Type of grout (circle one): Cement Casing length: <u>85</u> feet Casin	th: <u>125</u> Rentonite Mix ag diameter: <u>16</u>	air line other: Well grouted to a depth of inches Type of casing: _inches Type of screen:	10 feet PVC Sch.40	
Hole depth: 125 Well dep Type of grout (circle one): Cement Casing length: 85 feet Casin Screen length: 40 feet Screen Screen slot size: 050 inches	th: <u>125</u> Rentonite Mix ag diameter: <u>16</u> en diameter: <u>16</u> Setting depth: From	air line other: Well grouted to a depth of inches Type of casing: inches Type of screen: 86feet to	10 feet PVC Sch.40 PVC Sch.40 125 feet	
Hole depth: <u>125</u> Well dep Type of grout (circle one): Cement Casing length: <u>85</u> feet Casin Screen length: <u>40</u> feet Scree	th: <u>125</u> Rentonite Mix ag diameter: <u>16</u> en diameter: <u>16</u> Setting depth: From Gravel packed Underre	air line other: Well grouted to a depth of inches Type of casing: _inches Type of screen: 86feet to amed Telescoped Open	10feetPVC Sch. 40PVC Sch. 40125feetholeNatural Development	
Hole depth: 125 Well dep Type of grout (circle one): Cement Casing length: 85 feet Casin Screen length: 40 feet Screen Screen slot size: 050 inches	th: <u>125</u> Rentonite Mix ag diameter: <u>16</u> en diameter: <u>16</u> Setting depth: From Gravel packed Underre	air line other: Well grouted to a depth of inches Type of casing: inches Type of screen: 86feet to	10feetPVC Sch. 40PVC Sch. 40125feetholeNatural Development	
Hole depth: 125 Well dep Type of grout (circle one): Cement Casing length: 85 feet Casin Screen length: 40 feet Screen Screen slot size: 050 inches	th:125 Bentonite Mix g diameter:16 en diameter:16 Setting depth: From Gravel packet Underree Other (describe):	air line other: Well grouted to a depth of inches Type of casing: _inches Type of screen: 86feet to amed Telescoped Open	10 feet PVC Sch. 40 PVC Sch. 40 125 feet bole Natural Development	
Hole depth: <u>125</u> Well dep Type of grout (circle one): Cement Casing length: <u>85</u> feet Casin Screen length: <u>40</u> feet Scree Screen slot size: <u>050</u> inches Type of completion (circle all applicable): Top of lap pipe or reduction in casing:	th:125 Bentonite Mix g diameter:16 en diameter:16 Setting depth: From Gravel packed Underre Other (describe): feet. If teles	air line other: Well grouted to a depth of inches Type of casing: inches Type of screen: inches Type of screen: amed Telescoped Open scoped or more than one scr Scoped or more than one scr	10 feet PVC Sch. 40 PVC Sch. 40 125 feet bole Natural Development een, describe on back of page	
Hole depth: <u>125</u> Well dep Type of grout (circle one): Cement Casing length: <u>85</u> feet Casin Screen length: <u>40</u> feet Scree Screen slot size: <u>050</u> inches Type of completion (circle all applicable): Top of lap pipe or reduction in casing: Logs run (circle all applicable): to log run	th:125 Bentonite Mix g diameter:16 en diameter:16 Setting depth: From Gravel packed Underre Other (describe): feet. If teles	air line other: Well grouted to a depth of inches Type of casing: inches Type of screen: inches Type of screen: amed Telescoped Open scoped or more than one scr Scoped or more than one scr	10 feet PVC Sch. 40 PVC Sch. 40 125 feet bole Natural Development een, describe on back of page	
Hole depth: <u>125</u> Well dep Type of grout (circle one): Cement Casing length: <u>85</u> feet Casin Screen length: <u>40</u> feet Scree Screen slot size: <u>050</u> inches Type of completion (circle all applicable): Top of lap pipe or reduction in casing: Logs run (circle all applicable): to log run Name of organization running log(s):	th:125 Rentonite Mix g diameter:16 en diameter:16 Setting depth: From Gravel packed Underre Other (describe): feet. If teles Electric Gamma Ray	air line other: Well grouted to a depth of inches Type of casing: inches Type of screen: 86feet to camed Telescoped Open scoped or more than one scr Density Sonic Neutron	10 feet PVC Sch.40 PVC Sch.40 125 feet hole Natural Development een, describe on back of page Other:	
Hole depth: 125 Well dep Type of grout (circle one): Cement Casing length: 85 feet Casin Screen length: 40 feet Screet Screen slot size: 050 inches Type of completion (circle all applicable): Top of lap pipe or reduction in casing: Logs run (circle all applicable): Yo log run Name of organization running log(s): I certify that the well was drilled, construction	th:125 Bentonite Mix ag diameter:16 en diameter:16 Setting depth: From Gravel packed Underree Other (describe): feet. If teles Electric Gamma Ray	air line other: Well grouted to a depth of inches Type of casing: _inches Type of screen: 86feet to amed Telescoped Open scoped or more than one scr Density Sonic Neutron	10 feet PVC Sch.40 PVC Sch.40 125 feet bole Natural Development een, describe on back of page Other:	
Hole depth: 125 Well dep Type of grout (circle one): Cement Casing length: 85 feet Casin Screen length: 40 feet Screet Screen slot size: 050 inches Type of completion (circle all applicable): Top of lap pipe or reduction in casing: Logs run (circle all applicable): to log run Name of organization running log(s): I certify that the well was drilled, constru Department of Environmental Quality and	th:125 Rentonite Mix ag diameter:16 en diameter:16 Setting depth: From Gravel packed Underree Other (describe): feet. If teles Electric Gamma Ray ucted, and completed in ac nd/or the Mississippi Depa	air line other: Well grouted to a depth of inches Type of casing: _inches Type of screen: 86feet to amed Telescoped Open scoped or more than one scr Density Sonic Neutron	10 feet PVC Sch. 40 PVC Sch. 40 125 feet bole Natural Development een, describe on back of page Other:	
Hole depth: 125 Well dep Type of grout (circle one): Cement Casing length: 85 feet Casin Screen length: 40 feet Screet Screen slot size: .050 inches Type of completion (circle all applicable): Top of lap pipe or reduction in casing: Logs run (circle all applicable): to log run Name of organization running log(s): I certify that the well was drilled, constru Department of Environmental Quality an Irrigation Equipment	th:125 Bentonite Mix ag diameter:16 en diameter:16 Setting depth: From Gravel packed Underre Other (describe): feet. If teles Electric Gamma Ray ucted, and completed in ac nd/or the Mississippi Depa ent Inc.	air line other: Well grouted to a depth of inches Type of casing: _inches Type of screen: 86feet to amed Telescoped Open scoped or more than one scr Density Sonic Neutron	10 feet PVC Sch. 40 PVC Sch. 40 125 feet bole Natural Development een, describe on back of page Other:	
Hole depth: 125 Well dep Type of grout (circle one): Cement Casing length: 85 feet Casin Screen length: 40 feet Screet Screen slot size: 050 inches Type of completion (circle all applicable): Top of lap pipe or reduction in casing: Logs run (circle all applicable): to log run Name of organization running log(s): I certify that the well was drilled, constru Department of Environmental Quality and	th:125 Rentonite Mix g diameter:16 en diameter:16 Setting depth: From Gravel packed Underre Other (describe): feet. If teles Electric Gamma Ray ucted, and completed in ac nd/or the Mississippi Depa ent Inc. 0695	air line other: Well grouted to a depth of inches Type of casing: inches Type of screen: 86feet to camed Telescoped Open scoped or more than one scr Density Sonic Neutron cordance with all applicable artment of Health regulation	10 feet PVC Sch.40 PVC Sch.40 125 feet bole Natural Development een, describe on back of page Other:	

RECEIVED JUN 13 2006 8Y: OLWR

If well telescopes please sketch below and show depths.


Ground Level

Description of Formations Encountered	From	To
	0	35
Clay Fine Sand/gravel Med. Sand/gravel	36	65
Med Sand/gravel		125
Meu. Janu/ yraver		
	<u> </u>	
	ļ	
	İ	
		1
	<u> </u>	1-1
		<u>+</u>
		╂───┤
		-
		11
	+	+
		╉═╌╌┫
	1	

\$

.

If more than one screen, show location of each on sketch

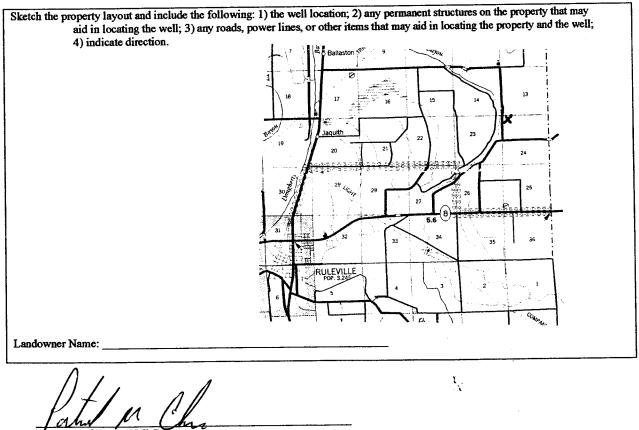

Signature of Water Well Contractor

County: Sunflower Permit #: GW 9/108 Irrigation Equipment Date completed: 5-26-06 Copy information from block on Part 1 This part of the report must be completed b report must be attached and both parts file. Well Owner Information Owner Name: Fletcher Clark Mailing Address: 3830 Hwy. 49	Pump Installer [*] Mississippi Departmen Office of Land P.O. Jackson, N (601 (601)35 by a licensed water well d with the Department of on	nt the above address within 30 d Wel	For Office Use Only: Aquifer: Well #: <u>F</u> - 133 Elevation: Installer. A copy of Part 1 of the ays of well completion.	
Irrigation Equipment Driller: Date completed:5-26-06 <u>Copy information from block on Part 1</u> This part of the report must be completed by report must be attached and both parts file. Well Owner Information Owner Name:Fletcher Clark	Mississippi Departmen Office of Land P.O. Jackson, N (601 (601)35 by a licensed water well d with the Department of on	nt of Environmental Quality and Water Resources Box 10631 MS 39289-0631)961-5210 i4-6938 (fax) contractor or a licensed pump in at the above address within 30 d Wef	Well #: <u>F - 133</u> Elevation: Installer. A copy of Part 1 of the ays of well completion.	
Irrigation Equipment Driller: Date completed:5-26-06 <u>Copy information from block on Part 1</u> This part of the report must be completed by report must be attached and both parts file. Well Owner Information Owner Name:Fletcher Clark	P.O. Jackson, N (601) (601) y a licensed water well d with the Department of on	Box 10631 MS 39289-0631)961-5210 i4-6938 (fax) contractor or a licensed pump in at the above address within 30 d Web	Elevation:	
Date completed: <u>5-26-06</u> <u>Copy information from block on Part 1</u> This part of the report must be completed by report must be attached and both parts file. Well Owner Information Owner Name: Fletcher Clark	Jackson, R (601) (601) y a licensed water well d with the Department of on	MS 39289-0631)961-5210 i4-6938 (fax) contractor or a licensed pump is at the above address within 30 d Web	Elevation:	
Copy information from block on Part 1 This part of the report must be completed b report must be attached and both parts file. Well Owner Information Owner Name: Fletcher Clark	(601)35 by a licensed water well <u>d with the Department t</u> on	4-6938 (fax) contractor or a licensed pump in at the above address within 30 d Web	nstaller. A copy of Part 1 of the ays of well completion.	
report must be attached and both parts file. Well Owner Informati Owner Name: Fletcher Clark	<i>d with the Department (</i> on	nt the above address within 30 d Wel	ays of well completion.	
Well Owner Informati Owner Name: Fletcher Clark	on	Wel	Location	
Owner Name: Fletcher Clark				
		Latitude:	Longitude:	
Mailing Address: <u>5650 Hwy</u> 45)	Method of Lat/Long (check or		
	Mailing Address: <u>3830 Hwy</u> 49		USGS quad, Hand-held GPS, Survey-grade GPS_	
Ruleville M	IS 38771			
City State	ZipCode	Zip Code		
662-756-283	31	Distance Direction		
Telephone No. ()		<u>6</u> <u>Miles</u> <u>NE</u> o	f_Ruleville	
Ритр Туре		Po	wer Type	
Circle one		C C	ircle one	
Air Lift Jet	Submersible	Diesel Engine Gasolin	ne Engine Natural G	
Bucket Piston	Turbine	Electric Motor Hand	Tractor PI	
Centrifugal Rotary	Flowing Well	Windmill Other	(specify):	
Other (specify):		Horse Power Rating of Motor	. 60	
Date Pump Installed: 5-27-06		Setting Depth:80feet		
Rated Pump Capacity:		Number of Stages:		
Pump Test Data			easuring Water Level Circle one	
Date Well Tested:		Air Line Electric Me	asuring Line Steel Tape	
Static Water Level (A):Feet Below Land Surface		Other (specify):		
Pumping Water Level (B):Feet I	Below Land Surface			
Drawdown [(B) - (A)]:Feet Below Land Surface		For flowing well, measured s	hut in head:f	
Test Pumping Rate:	Gallons Per Minute	Well yielded	GPM with a drawdown of	
Duration of Pump Test (minimum 4 hours):	hours	feet after _	hours of pump	
		<u> </u>		
I HEREBY CERTIFY that the above statem	nents are true to the best	of my knowledge.	/	

JUN 1 3 2006

BY: OLWR