\ 	State W	ell Report			
County: Sunflower		art 1	For Office Use Only:		
	i .	Mississippi Department of Environmental Quality			
Permit #: 6w 41736	Office of Land a	Office of Land and Water Resources			
Irrigation Equipment		Sox 10631	Well #:		
4-6-07		S 39289-0631 961-5210	L. S. Elevation:		
Date drilling completed:	(601)961-5210 (601)354-6938 (fax)		E-log #:		
			4 4 24		
State Law requires that this report be prepared by the driller in detail and filed with the Department within					
30 days of completion of drilling Well Owner Inform		Well	Location		
Borodofsky Properties					
Owner Name	<u> </u>	Latitude:o'	" Longitude:"		
Mailing Address: C/o Land Mgt. Group Method of Lat/Long (circle one): Conventional Survey,			ne): Conventional Survey,		
3426 Amroth Drive		NWUSGS quad, Hand-held			
- 120 AMITOCH DIIVE		NE NE 32	2 Twn 22N Rng 3W		
Collierville	e TN 38017	/4 Sec	I MII KHR		
901-850-5	303	Miles Fast	of Ruleville		
Telephone No. ()					
	Well	Data	-		
D CAN H ( ' 1 and Hame	Accepted Dublic Complex	Irrigation Fish Culture	Other:		
Purpose of Well (circle one) Home In	dustrial Public Supply	Tish Culture			
Date well drilling started: 4-6-	Date v	well drilling completed:4	1-6-07		
If flowing, method of flow regulation: V	alveOther (d	lescribe)	- 4 colors		
Static Water Level:34 'feet a	shave or below (circle one)	land surface Date measured:	4-7-07		
	$\sim$				
Method of Measurement (circle one)	steel tape electric tape	air line other:			
Hole depth: 137 Well depth: 137 Well grouted to a depth of 10 feet					
*	,				
-71	Bentonite Mix				
Casing length: 97 feet Cas	sing diameter: 16	inches Type of casing:	PVCSCH40		
		inches . Type of screen: _			
Screen slot size: . 050 inches		58 feet to	97 <b>feet</b>		
Type of completion (circle all applicable	): Gravel packed Unde	rreamed Telescoped Ope	n hole Natural Development		
	Other (describe)				
Top of lap pipe or reduction in casing:feet. If telescoped or more than one screen, describe on back of page					
Logs run (circle all applicable): No log i	run Electric Gamma Ray	Density Sonic Neutron	Other:		
Name of organization running log(s):  I certify that the well was drilled, cons	tructed, and completed in	accordance with all applicable	le requirements of the Mississippi		

Department of Environmental Quality and/or the Mississippi Department of Health regulations and state laws.

Irrigation Equipment Inc.

Patrick M. Chism

Print Name of Water Well Contractor and License No.

RECEIVED

Signature of Water Well Contractor

MAY 0 1 2007

BY: OLWR


F-'

If well telescopes please sketch below and show depths.

Ground Level

Description of Formations Encountered	From	To
Clay	0	39
Fine Sand	40	45
Fine Sand/gravel	46	55
Fine Sand/gravel Med. Sand/gravel	56	95
Clav	96	104
Fine Sand	105	137
	ļ	$\vdash$
	ļ	<b> </b>
·	ļ	<b></b>
	ļ <u> </u>	
	<u> </u>	
	ļ	<u> </u>
		L
	<u> </u>	
	<b> </b>	
	<u></u>	

If more than one screen, show location of each on sketch

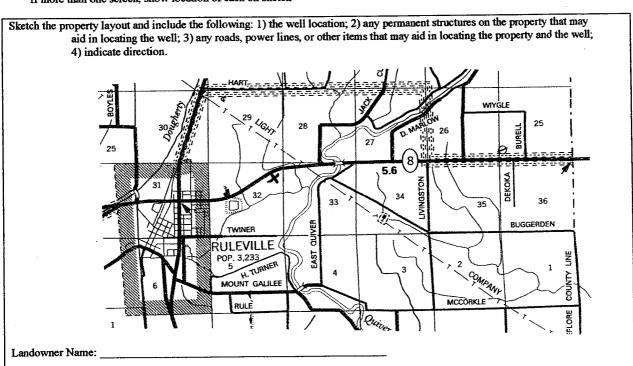

Signature of Water Well Contractor

## STATE WELL REPORT

## Sunflower Permit #: 6W 41736

## Part 2

Pump Installer's Completion Report Mississippi Department of Environmental Quality Office of Land and Water Resources P.O. Box 10631 Jackson, MS 39289-0631

For Office Use Only:		
Aquifer:		
Well#: _	F-135	
Elevation:		

Date completed: 4-6-07	(601)961-5210 (601)354-6938 (fax) Elevation:			
This report should be prepared by the pump installation of pump.	installer in detail and filed with the Department within 30 days of the			
<b>Well Owner Information</b> Borodofsky Properties				
Owner Name: c/o Land Mgt. Gro	Latitude: Longitude:			
3426 Amroth Drive				
Collierville TN	38017			
City State Zi 901-850-5303 Telephone No. ()	Distance Direction Nearest Town			
Pum p Type Circle one	Power Type Circle one			
Air Lift Jet Submers	sible Diesel Engine Gasoline Engine Natural Gas			
Bucket Piston Turbine	Electric Motor Hand Tractor PTO			
Centrifugal Rotary Flowing	Well Windmill Other (specify):			
Other (specify): 4-7-07	Horse Power Rating of Motor: 40			
Rated Pump Capacity: 1500± Gallons P	Setting Depth: 80 feet  Ver Minute Number of Stages: 3			
Pump Test Data	Method of Measuring Water Level Circle one			
Date Well Tested: Feet Below Lan  Pumping Water Level (B): Feet Below Lan	Air Line Electric Measuring Line Steel Tape  Other (specific):			
Drawdown [(B) - (A)]:Feet Below Lan	· · · · · · · · · · · · · · · · · · ·			
Test Pumping Rate: Gallons Pe				
Duration of Pump Test (minimum 4 hours): hours feet after hours of pumping				

I HEREBY CERTIFY that the above statements are true to the best of my k Patrick M. Chism 0695 Print Name of Pump Installer and License No. (if applicable) Signature of Pump Installer

MAY 0 1 2007

BY: OLWR