

County: Sunflower
 Permit #: 043171
 Driller: Irrigation Equipment
 Date drilling completed: 4/25/09

State Well Report

Part 1

Mississippi Department of Environmental Quality
 Office of Land and Water Resources
 P.O. Box 10631
 Jackson, MS 39289-0631
 (601)961-5210
 (601)354-6938 (fax)

For Office Use Only:
 Aquifer: _____
 Well #: F-151
 L. S. Elevation: _____
 E-log #: _____

State Law requires that this report be prepared by the driller in detail and filed with the Department within 30 days of completion of drilling of the well.

Well Owner Information	Well Location
Owner Name: <u>Rusty McIntyre</u>	Latitude: _____ Longitude: _____
Mailing Address: <u>8 East McIntyre Rd</u>	Method of Lat/Long (circle one): <input type="radio"/> Conventional Survey, <input type="radio"/> USGS quad, <input type="radio"/> Hand-held GPS, <input type="radio"/> Survey-grade GPS
<u>Drew</u> <u>Ms.</u> <u>38737</u> City State Zip Code	<u>NW 1/4 NW 1/4</u> Sec <u>7</u> Twn <u>22N</u> Rng <u>3W</u>
Telephone No. <u>(662) 745-8413</u>	Distance _____ Direction <u>SW</u> of <u>Drew</u>

Well Data

Purpose of Well (circle one) Home Industrial Public Supply Irrigation Fish Culture Other: _____

Date well drilling started: 4/25/09 Date well drilling completed: 4/25/09

If flowing, method of flow regulation: Valve _____ Other (describe) _____

Static Water Level: 42 feet above or below (circle one) land surface Date measured: 4/27/09

Method of Measurement (circle one) steel tape electric tape air line other: _____

Hole depth: 120 Well depth: 120 Well grouted to a depth of 10 feet

Type of grout (circle one): Cement Bentonite Mix

Casing length: 80 feet Casing diameter: 10 inches Type of casing: PVC

Screen length: 40 feet Screen diameter: 10 inches Type of screen: PVC

Screen slot size: .050 inches Setting depth: From 76 feet to 115 feet

Type of completion (circle all applicable): Gravel packed Underreamed Telescoped Open hole Natural Development
 Other (describe): _____

Top of lap pipe or reduction in casing: _____ feet. If telescoped or more than one screen, describe on back of page

Logs run (circle all applicable) No log run Electric Gamma Ray Density Sonic Neutron Other: _____

Name of organization running log(s): _____

I certify that the well was drilled, constructed, and completed in accordance with all applicable requirements of the Mississippi Department of Environmental Quality and/or the Mississippi Department of Health regulations and state laws.

Irrigation Equipment Inc.
 John P. Chism 0439

Print Name of Water Well Contractor and License No. _____

John P. Chism
 Signature of Water Well Contractor

RECEIVED
 APR 30 2009
 BY: OLWH

STATE WELL REPORT

Part 2

Pump Installer's Completion Report
 Mississippi Department of Environmental Quality
 Office of Land and Water Resources
 P.O. Box 10631
 Jackson, MS 39289-0631
 (601)961-5210
 (601)354-6938 (fax)

County: Sunflower
 Permit #: 6643171
 Irrigation Equipment
 Driller:
 Date completed: 4/25/09

For Office Use Only:

Aquifer: _____
 Well #: F-151
 Elevation: _____

This report should be prepared by the pump installer in detail and filed with the Department within 30 days of the installation of pump.

Well Owner Information	Well Location
Owner Name: <u>Rusty McIntyre</u>	Latitude: _____ Longitude: _____
Mailing Address: <u>8 East McIntyre Rd</u>	Method of Lat/Long (circle one): <input type="radio"/> Conventional Survey, <input type="radio"/> USGS quad, <input type="radio"/> Hand-held GPS, <input type="radio"/> Survey-grade GPS
<u>Drew</u> <u>Ms.</u> <u>38737</u> City State Zip Code	<u>NW 1/4 NW 1/4 Sec 7 Twn 22N Rng 3W</u>
Telephone No. <u>(662) 745-8413</u>	Distance Direction Nearest Town <u>1</u> Miles <u>SW</u> of <u>Drew</u>

Pump Type Circle one	Power Type Circle one
<input type="checkbox"/> Air Lift <input type="checkbox"/> Jet <input checked="" type="checkbox"/> <u>Submersible</u> <input type="checkbox"/> Bucket <input type="checkbox"/> Piston <input type="checkbox"/> Turbine <input type="checkbox"/> Centrifugal <input type="checkbox"/> Rotary <input type="checkbox"/> Flowing Well Other (specify): _____ Date Pump Installed: <u>4/27/09</u> Rated Pump Capacity: <u>550 ±</u> Gallons Per Minute	<input type="checkbox"/> Diesel Engine <input type="checkbox"/> Gasoline Engine <input type="checkbox"/> Natural Gas <input checked="" type="checkbox"/> <u>Electric Motor</u> <input type="checkbox"/> Hand <input type="checkbox"/> Tractor PTO <input type="checkbox"/> Windmill Other (specify): _____ Horse Power Rating of Motor: <u>10</u> Setting Depth: <u>80</u> feet Number of Stages: <u>1</u>

Pump Test Data	Method of Measuring Water Level Circle one
Date Well Tested: _____	<input type="checkbox"/> Air Line <input type="checkbox"/> Electric Measuring Line <input type="checkbox"/> Steel Tape
Static Water Level (A): _____ Feet Below Land Surface	Other (specify): _____
Pumping Water Level (B): _____ Feet Below Land Surface	For flowing well, measured shut in head: _____ feet
Drawdown [(B) - (A)]: _____ Feet Below Land Surface	Well yielded _____ GPM with a drawdown of _____ feet after _____ hours of pumping
Test Pumping Rate: _____ Gallons Per Minute	
Duration of Pump Test (minimum 4 hours): _____ hours	

I HEREBY CERTIFY that the above statements are true to the best of my knowledge.

John P. Chism 0439
 Print Name of Pump Installer and License No. (if applicable) Signature of Pump Installer


RECEIVED

APR 30 2009

BY: OLWH

26-43171

F-151

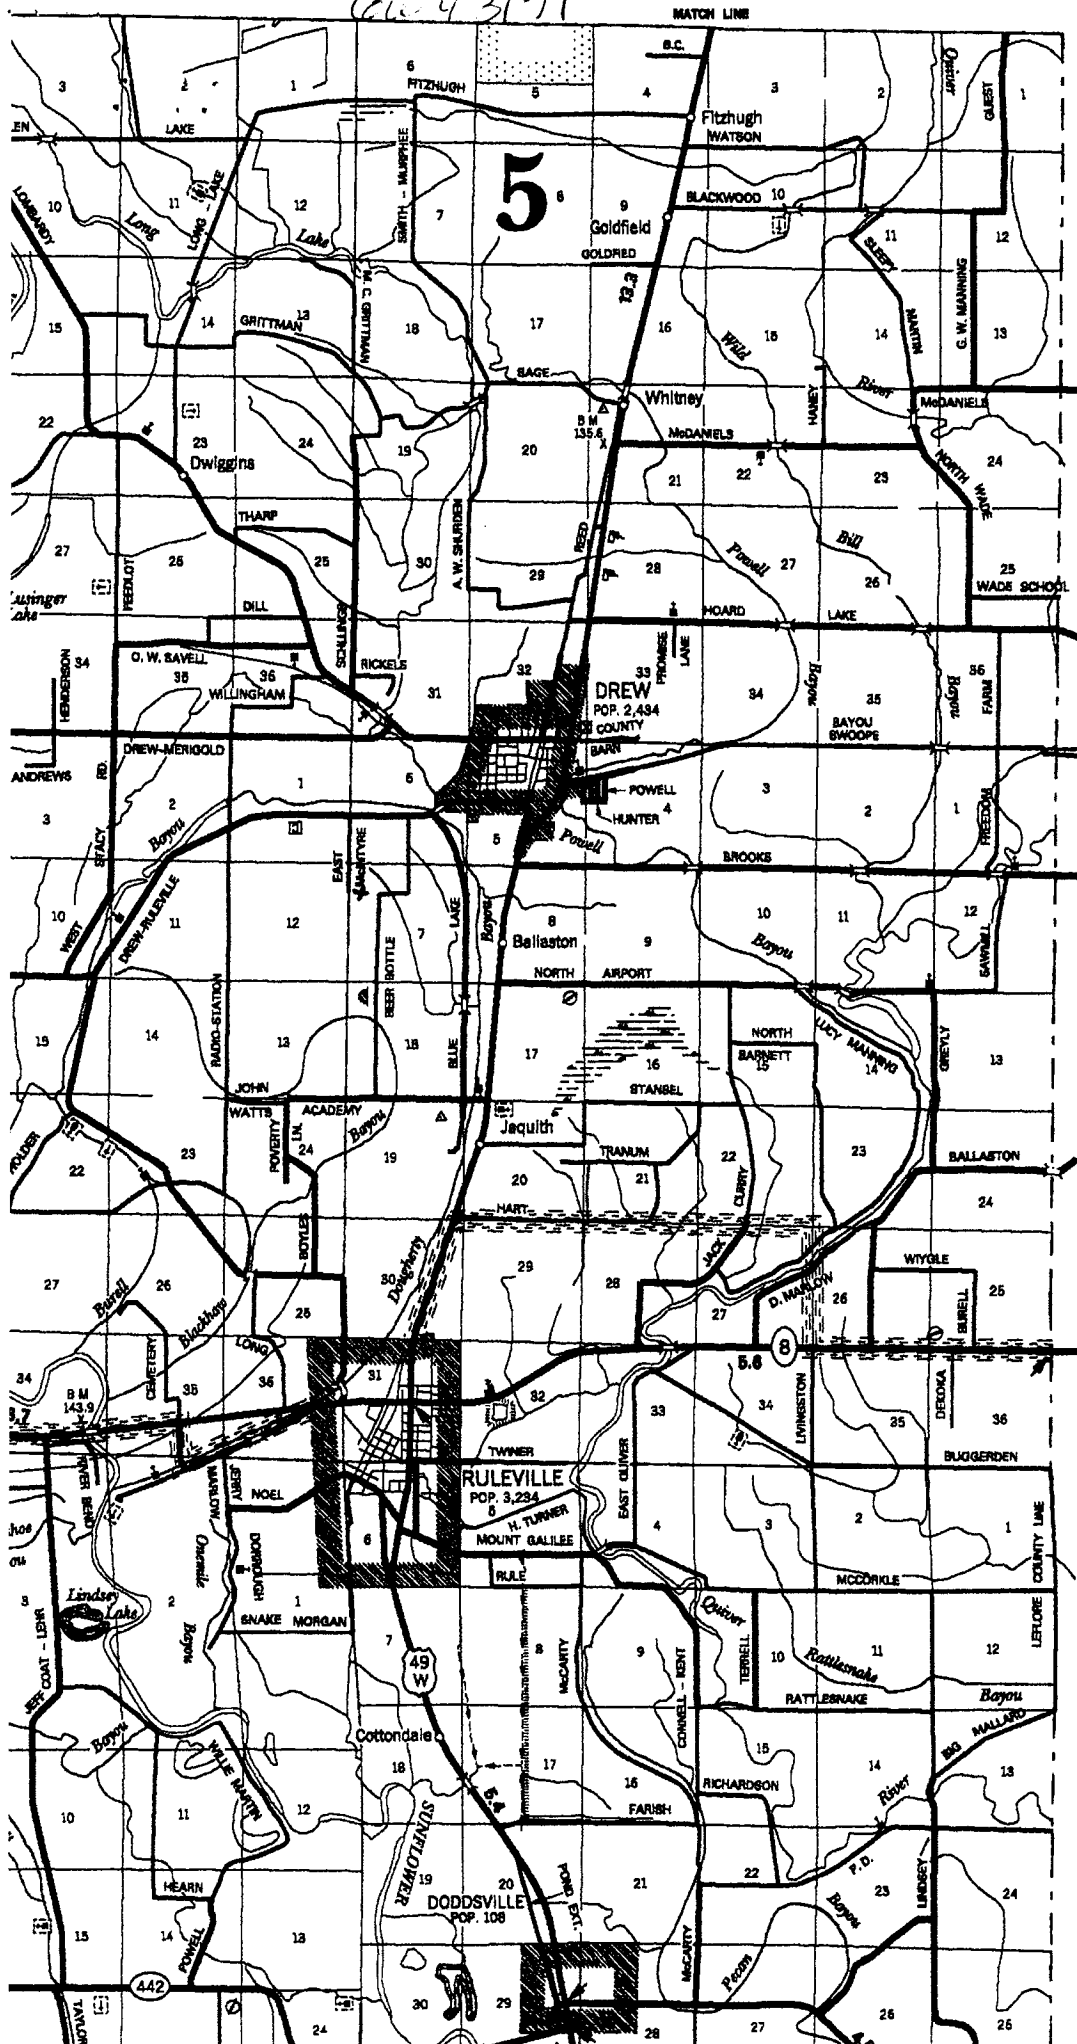

T 23 N

T 22 N

To Minter City →

To Minter City →

Rusty McIntyre Map

LEFLORE COUNTY

RECEIVED
 APR 30 2009
 BY: OLWR

A

B

C

33° 50'

33° 45'

33° 40'

480 000 m

470 000 m

0 m