

State Well Report

Part 1

Mississippi Department of Environmental Quality
Office of Land and Water Resources
P.O. Box 10631
Jackson, MS 39289-0631
(601)961-5210
(601)354-6938 (fax)

For Office Use Only:

Aquifer: _____
Well #: F-152
L. S. Elevation: _____
E-log #: _____

County: Sunflower
Permit #: 20043176
Irrigation Equipment
Driller: _____
Date drilling completed: 4/27/09

State Law requires that this report be prepared by the driller in detail and filed with the Department within 30 days of completion of drilling of the well.

Well Owner Information	Well Location
Owner Name: <u>Borodofsky Properties</u>	Latitude: _____ Longitude: _____
Mailing Address: <u>Go Land Management Group</u>	Method of Lat/Long (circle one): Conventional Survey, USGS quad, Hand-held GPS, Survey-grade GPS
<u>1196 Poplar View Lane S Suite 1</u>	<u>SW₄ SW₄ Sec 29 Twn 22N Rng 3W</u>
<u>Collierville Tn: 38017</u>	Distance _____ Direction _____ Nearest Town _____
City _____ State _____ Zip Code _____	<u>1</u> Miles <u>NE</u> of <u>Ruleville</u>
Telephone No. <u>901-850-5303</u>	

Well Data

Purpose of Well (circle one) Home Industrial Public Supply Irrigation Fish Culture Other: _____

Date well drilling started: 4/27/09 Date well drilling completed: 4/27/09

If flowing, method of flow regulation: Valve _____ Other (describe) _____

Static Water Level: 49 feet above or below (circle one) land surface Date measured: 4/29/09

Method of Measurement (circle one) steel tape electric tape air line other: _____

Hole depth: 116 Well depth: 116 Well grouted to a depth of 10 feet

Type of grout (circle one): Cement Bentonite Mix

Casing length: 76 feet Casing diameter: 16 inches Type of casing: PVC

Screen length: 40 feet Screen diameter: 16 inches Type of screen: PVC

Screen slot size: .050 inches Setting depth: From 61 feet to 100 feet

Type of completion (circle all applicable): Gravel packed Underreamed Telescoped Open hole Natural Development

Other (describe): _____

Top of lap pipe or reduction in casing: _____ feet. If telescoped or more than one screen, describe on back of page

Logs run (circle all applicable) No log run Electric Gamma Ray Density Sonic Neutron Other: _____

Name of organization running log(s): _____

I certify that the well was drilled, constructed, and completed in accordance with all applicable requirements of the Mississippi Department of Environmental Quality and/or the Mississippi Department of Health regulations and state laws.

Irrigation Equipment Inc.
John P. Chism 0439

Print Name of Water Well Contractor and License No. _____

John P. Chism
Signature of Water Well Contractor

RECEIVED

MAY 05 2009

BY: OLWH

STATE WELL REPORT

Part 2

Pump Installer's Completion Report
Mississippi Department of Environmental Quality
Office of Land and Water Resources
P.O. Box 10631
Jackson, MS 39289-0631
(601)961-5210
(601)354-6938 (fax)

County: Sunflower
Permit #: 4043176
Irrigation Equipment
Driller: _____
Date completed: 4/27/09

For Office Use Only:

Aquifer: _____
Well #: F-152
Elevation: _____

This report should be prepared by the pump installer in detail and filed with the Department within 30 days of the installation of pump.

Well Owner Information	Well Location
Owner Name: <u>Boredofsky Properties</u>	Latitude: _____ Longitude: _____
Mailing Address: <u>Go Land Management Group</u>	Method of Lat/Long (circle one): <u>Conventional Survey</u> , USGS quad, Hand-held GPS, Survey-grade GPS.
<u>1196 Poplar View Lane S, Suite 1</u>	SW $\frac{1}{4}$ SW $\frac{1}{4}$ Sec <u>29</u> Twn <u>22N</u> Rng <u>3W</u>
<u>Collierville Tn. 38017</u>	Distance Direction Nearest Town
City State Zip Code	<u>1</u> Miles <u>NE</u> of <u>Rulerille</u>
Telephone No. () _____	

Pump Type Circle one	Power Type Circle one
Air Lift Jet Submersible	<u>Diesel Engine</u> Gasoline Engine Natural Gas
Bucket Piston <u>Turbine</u>	Electric Motor Hand Tractor PTO
Centrifugal Rotary Flowing Well	Windmill Other (specify): _____
Other (specify): _____	Horse Power Rating of Motor: <u>60</u>
Date Pump Installed: <u>4/29/09</u>	Setting Depth: <u>80</u> feet
Rated Pump Capacity: <u>2300±</u> Gallons Per Minute	Number of Stages: <u>2</u>


Pump Test Data	Method of Measuring Water Level Circle one
Date Well Tested: _____	Air Line Electric Measuring Line Steel Tape
Static Water Level (A): _____ Feet Below Land Surface	Other (specify): _____
Pumping Water Level (B): _____ Feet Below Land Surface	For flowing well, measured shut in head: _____ feet
Drawdown [(B) - (A)]: _____ Feet Below Land Surface	Well yielded _____ GPM with a drawdown of _____ feet after _____ hours of pumping
Test Pumping Rate: _____ Gallons Per Minute	
Duration of Pump Test (minimum 4 hours): _____ hours	

I HEREBY CERTIFY that the above statements are true to the best of my knowledge.

John P. Chism 0439
Print Name of Pump Installer and License No. (if applicable) John P. Chism
Signature of Pump Installer

RECEIVED
MAY 05 2009
BY: OLWR

F-152

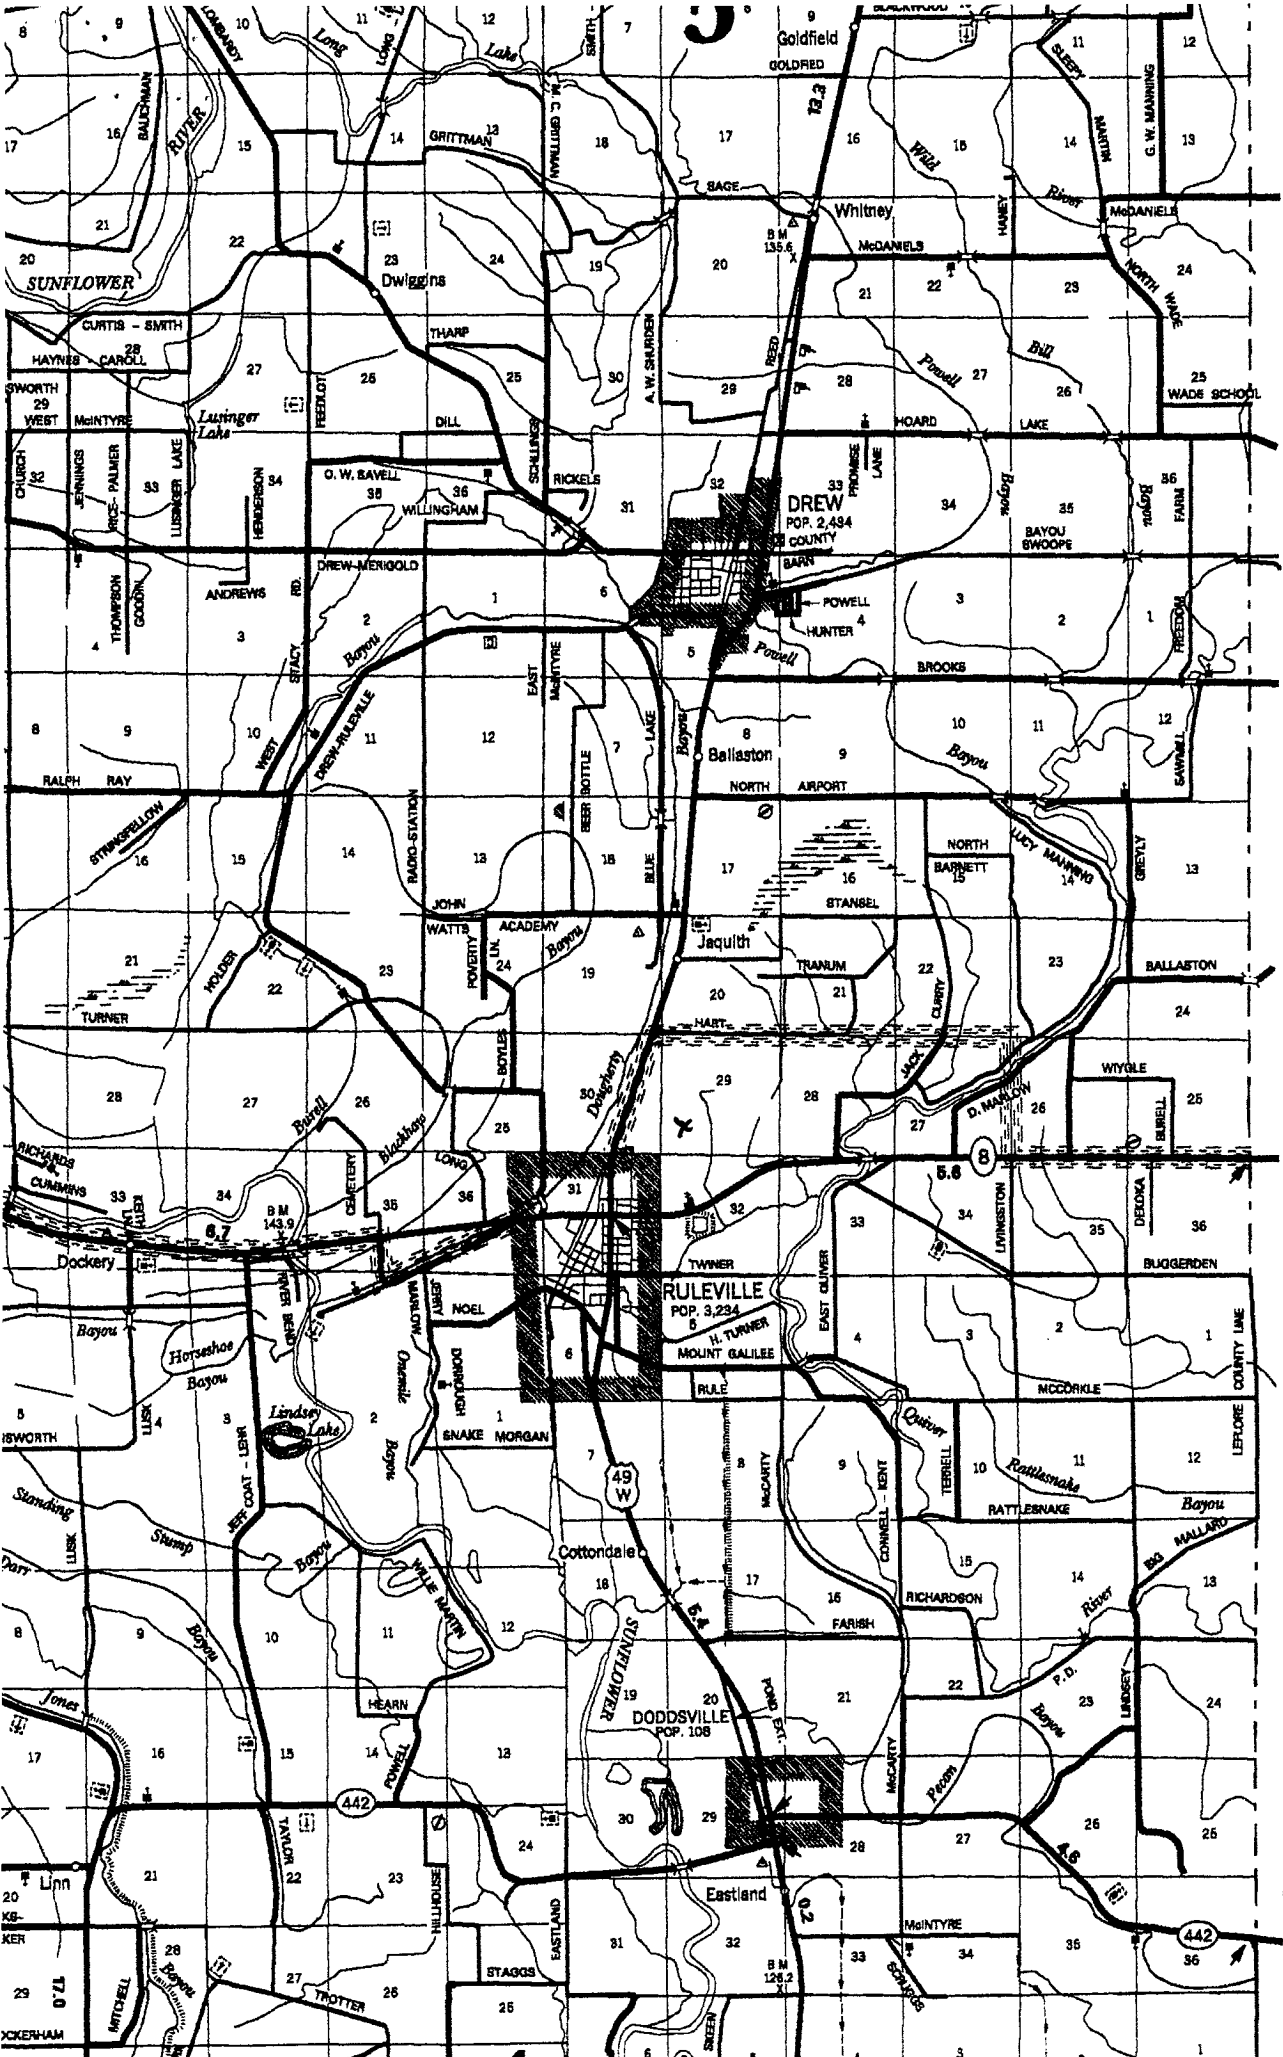

TALLAHATCHIE COUNTY
T 23 N

T 22 N

To Minter City →

LEFLORE COUNTY
T 21 N

RECEIVED
MAY 05 2009
BY: OLWR

Borodatsky Properties