

SUNFLOWER

F 2001

8/31/77

MISSISSIPPI BOARD OF WATER COMMISSIONERS  
416 North State Street  
154 Jackson, Mississippi 39201

WATER WELL DRILLERS LOG

BUTANE GAS CO. OF GREENWOOD Sunflower

8-31-77

date well completed

firm name

county well located


| LANDOWNER:                                           | description of formations encountered | from | to  |
|------------------------------------------------------|---------------------------------------|------|-----|
| Lester Bayless                                       |                                       |      |     |
| Ruleville                                            | Sand                                  | 10   | 50  |
| (mailing address)                                    | Sand & Gravel                         | 50   | 130 |
| WELL LOCATION:                                       | Sand                                  | 130  | 180 |
| sec. 23 T. 22 N R. 3 E                               | Clay                                  | 180  | 500 |
| 8 1/2 miles NE of Ruleville                          | Sand                                  | 500  | 640 |
| (distance) (direction) (nearest town)                | Clay                                  | 640  | 924 |
| WELL PURPOSE: Home                                   |                                       |      |     |
| (home, irrigation, municipal, industrial)            |                                       |      |     |
| WELL COMPLETION DATA:                                |                                       |      |     |
| (1) diameter (inches) 4 x 2                          |                                       |      |     |
| (2) total depth (feet) 986                           |                                       |      |     |
| (3) static water level (feet) 0 below top of ground. |                                       |      |     |
| (4) casing Steel, 966 (material) (depth)             |                                       |      |     |
| 4 x 2 (size) if telescope see back.                  |                                       |      |     |
| (5) screen 20' 966 (length) (depth to top)           |                                       |      |     |
| 2" stainless (size) (material)                       |                                       |      |     |
| (6) pump 1 20 (HP) (yield gpm)                       |                                       |      |     |
| Elec. (type power)                                   |                                       |      |     |
| (7) electric log no (yes or no)                      |                                       |      |     |
| (organization running log)                           |                                       |      |     |
| (8) how well bottom plugged head plug                |                                       |      |     |
| DRILLERS REMARKS:                                    |                                       |      |     |

RECEIVED  
SEP 26 1977

MISS. BU. OF WATER COMMISSIONERS

If well telescopes please sketch and show depths.

GROUND LEVEL

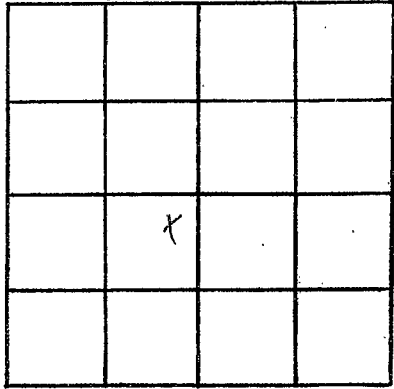

SECTION 2-3

Please indicate well location X.

ADDITIONAL INFORMATION

If more than one screen, show locations of each on sketch.