

Sunflower
F 2003

MISSISSIPPI
BOARD OF WATER COMMISSIONERS
416 North State Street
Jackson, Mississippi 39201

WATER WELL DRILLERS LOG

Schultz Drilling Co Sunflower

7-10-79

July 10 19

date well completed

firm name

county well located

LANDOWNER: Gene Bedner
Drew MS

description of formations encountered

from to

CLAY 0 20
CLAY SHALE 20 40
SAND + Pea Gravel 40 80

(mailing address)

WELL LOCATION:

sec. 15 T. 22 N R. 3 E
3 miles S of Drew
(distance) (direction) (nearest town)

WELL PURPOSE: municipal
(home, irrigation, municipal, industrial)

WELL COMPLETION DATA:

- (1) diameter (inches) 4"
- (2) total depth (feet) 80'
- (3) static water level (feet) 19' below top of ground
- (4) casing PVC 70' (material) (depth)
- (size) If telescope see back.
- (5) screen 10' 60' (length) (depth to top)
- APV PVC (size) (material)
- (6) pump 1 12 gpm (HP) (yield gpm)
- ele (type power)
- (7) electric log NO (yes or no)

Need 4" PVC


(organization running log)

(8) how well bottom plugged PVC Cap

DRILLERS REMARKS:

If well telescopes please sketch and show depths.

GROUND LEVEL

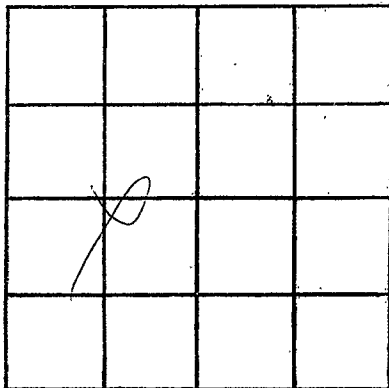

SECTION _____

Please indicate well location X.

ADDITIONAL INFORMATION

If more than one screen,
show locations of each on sketch.