

SUNFLOWER
F 200
10-29-80

MISSISSIPPI
 BOARD OF WATER COMMISSIONERS
 416 North State Street
 Jackson, Mississippi 39201

WATER WELL DRILLERS LOG

BUTANE GAS COMPANY
 OF GREENWOOD
 firm name

Oct 29 19 80
 date well completed

SUNFLOWER
 county well located

LANDOWNER: J.B. Smith
Rt 1 Box 107
Ruleville MS
 (mailing address)

description of formations encountered	from	to
Clay	0	10
SAND	10	50
GRAVEL	50	80
SAND - Choppy	80	100

WELL LOCATION:
 sec 28 T 22N R 3 E
2 miles NE of Ruleville
 (distance) (direction) (nearest town)

WELL PURPOSE: Home
 (home, irrigation, municipal, industrial)

- WELL COMPLETION DATA:
- (1) diameter (inches) 4"
 - (2) total depth (feet) 80'
 - (3) static water level (feet) 30' ^{below} _{above} top of ground.
 - (4) casing PVC, 80'
 (material) (depth)
4" if telescope see back.
 (size)
 - (5) screen 20', 60'
 (length) (depth to top)
4", PVC
 (size) (material)
 - (6) pump 1 1/2 10
 (HP) (yield gpm)
FIEC
 (type power)
 - (7) electric log No
 (yes or no)
No
 (organization running log)
 - (8) how well bottom plugged BACK PRESSURE VALVE


DRILLERS REMARKS:

DEPT. OF NATURAL RESOURCES
 BUREAU OF LAND & WATER RESOURCES

NOV -6 1980
 RECEIVED

If well telescopes please sketch and show depths.

GROUND LEVEL

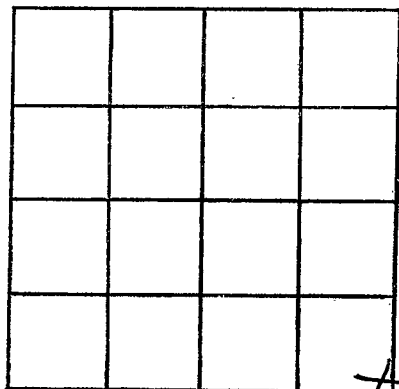

SECTION 28

Please indicate well location X.

ADDITIONAL INFORMATION

If more than one screen,
show locations of each on sketch.