

MISSISSIPPI DEPARTMENT OF NATURAL RESOURCES

Bureau of Land and Water Resources

Southport Mall

P.O. Box 10631

Jackson, Mississippi 39209

WATER WELL DRILLERS LOG

<u>Sunflower</u>
<u>F</u>
<u>2005</u>

November 6 1981 Bruce Berryman Sunflower
 date well completed firm name county well located
Greenwood

LANDOWNER: Robert Martin
 Rt. 1. Box 274
 Ruleville. MS 38771
 (mailing address)

WELL LOCATION:
 sec. 23 T. 22 N. R. 5 E
 S. 3 W
4 miles NE of Ruleville
 (distance) (direction) (nearest town)

WELL PURPOSE: HOME
 (home, irrigation, municipal, industrial)

WELL COMPLETION DATA:

(1) diameter (inches) 4" x 2"

(2) total depth (feet) 672'

(3) static water level (feet) 10 below top of ground. 126'

(4) casing 4" blk - 126'
2" galv - 526'
 (material) (depth)

 if telescope see back.
 (size)

(5) screen 20' , 652'
 (length) (depth to top)

2" .010 Stainless steel.
 (size) (material)

(6) pump 1 1/2 35
 (HP) (yield gpm)

Electric
 (type power)

(7) electric log NO
 (yes or no)

 (organization running log)

(8) how well bottom plugged B.P.V.

description of formations encountered	from	to
Clay	0	20
Sand	20	40
Sand & Gravel	40	180
Clay	180	190
Sand	190	240
Clay	240	250
Sand	250	280
Shale	280	340
Sand	340	360
Shale	360	480
Sandy shale	480	500
Sand	500	540
Clay	540	600
Sand	600	680
Shale	680	740
Sandy shale & rock	740	780
Shale	780	790
Sand	790	800
Shale	800	830
Sand	830	840

DRILLERS REMARKS:


DEPT. OF NATURAL RESOURCES
 BUREAU OF LAND & WATER RESOURCES

APR 27 1982

RECEIVED

If well telescopes please sketch and show depths.

GROUND LEVEL

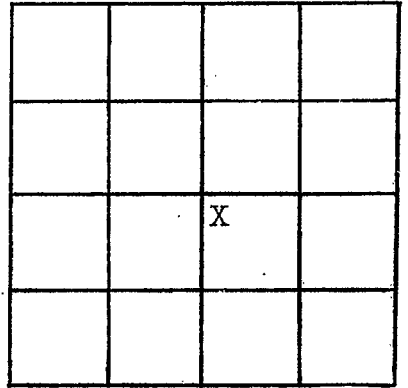

SECTION 23

Please indicate well location X.

ADDITIONAL INFORMATION

If more than one screen,
show locations of each on sketch.