

MISSISSIPPI DEPARTMENT OF NATURAL RESOURCES

Bureau of Land and Water Resources

Southport Mall

P.O. Box 10631

Jackson, Mississippi 39209

WATER WELL DRILLERS LOG

BUTANE GAS COMPANY

Sunflower
county well located

OF GREENWOOD

SUNFLOWER
F 2000
5-4-81

date well completed

19 81

LANDOWNER: John Mailer

description of formations encountered

from to

<u>Clay</u>	<u>0</u>	<u>10</u>
<u>sand</u>	<u>10</u>	<u>60</u>
<u>gravel</u>	<u>60</u>	<u>100</u>

(mailing address)

WELL LOCATION:

sec. 21 T. 22 N. R. 3 E
 (distance) 2 miles NE of Rekeville
 (direction) (nearest town)

WELL PURPOSE:

(Home, Irrigation, municipal, industrial)

WELL COMPLETION DATA:

- (1) diameter (inches) 4"
- (2) total depth (feet) 100'
- (3) static water level (feet) 30 below top of ground.
- (4) casing PVC 80
 (material) (depth)
 (size) if telescope see back.
- (5) screen 20' 80'
 (length) (depth to top)
4" PVC
 (size) (material)
- (6) pump 1 15
 (HP) (yield gpm)
Electric
 (type power)
- (7) electric log _____
 (yes or no)

 (organization running log)

(8) how well bottom plugged Backwash
Valve

DEPT. OF NATURAL RESOURCES
 BUREAU OF LAND & WATER RESOURCES


MAY 28 1981

DRILLERS REMARKS:

RECEIVED

If well telescopes please sketch and show depths.

GROUND LEVEL

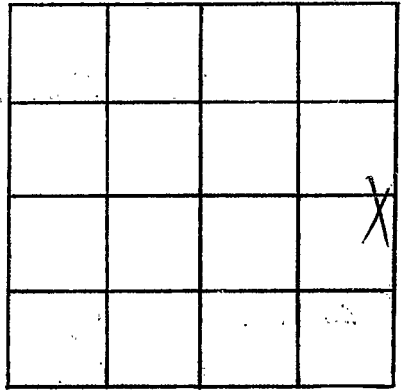

SECTION 21

Please indicate well location X.

ADDITIONAL INFORMATION

If more than one screen, show locations of each on sketch.