

MISSISSIPPI DEPARTMENT OF NATURAL RESOURCES

Bureau of Land and Water Resources

Southport Mall

P.O. Box 10631

Jackson, Mississippi 39209

WATER WELL DRILLERS LOG

Sunflower
F 2007
5-1-81

5-1-81
date well completed

1981 BUTANE GAS COMPANY

Sunflower

OF GREENWOOD

county well located

LANDOWNER: <u>COE Wilson</u>	description of formations encountered	from	to
(mailing address)	<u>CLAY</u>	<u>0</u>	<u>10</u>
WELL LOCATION: sec. <u>20</u> T <u>22</u> N R <u>3</u> E <u>2</u> miles <u>N</u> of <u>Ruleville</u> (distance) (direction) (nearest town)	<u>SAND</u>	<u>10</u>	<u>60</u>
WELL PURPOSE: (home, irrigation, municipal, industrial)	<u>GRAVEL</u>	<u>60</u>	<u>100</u>
WELL COMPLETION DATA:			
(1) diameter (inches) <u>4" PVC</u>			
(2) total depth (feet) <u>100'</u>			
(3) static water level (feet) <u>30</u> ^{below} _{above} top of ground.			
(4) casing <u>PVC</u> , <u>80'</u> (material) (depth)			
_____ if telescope see back. (size)			
(5) screen <u>20'</u> , <u>80'</u> (length) (depth to top)			
<u>4"</u> , <u>PVC</u> (size) (material)			
(6) pump <u>1</u> , <u>15</u> (HP) (yield gpm)			
<u>Electric</u> (type power)			
(7) electric log <u>No</u> (yes or no)			
_____ (organization running log)			
(8) how well bottom plugged <u>Back Wash</u>			
DRILLERS REMARKS:			


DEPT. OF NATURAL RESOURCES
BUREAU OF LAND & WATER RESOURCES

MAY 28 1981

RECEIVED

If well telescopes please sketch and show depths.

GROUND LEVEL

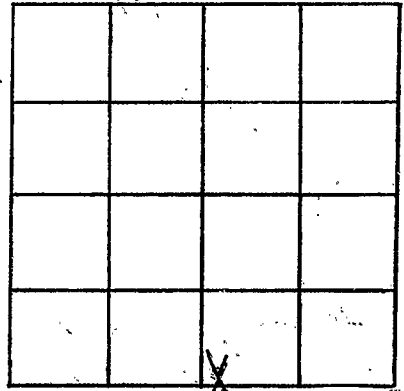

SECTION 20

Please indicate well location X.

ADDITIONAL INFORMATION

If more than one screen,
show locations of each on sketch.