

Sunflower
F
2006

MISSISSIPPI
 BOARD OF WATER COMMISSIONERS
 416 North State Street
 Jackson, Mississippi 39201

WATER WELL DRILLERS LOG

08-28-82
 date well completed

Hustin Gain Well Service
 firm name

Sunflower
 county well located

LANDOWNER: Don W. Williams
608 Thunderbird Ct
Chesterfield Mo 63017
 (mailing address)

description of formations encountered	from	to
	<u>Sandy Clay</u>	<u>0</u>
<u>Sand</u>	<u>20</u>	<u>62</u>
<u>Clay</u>	<u>62</u>	<u>75</u>
<u>Sand</u>	<u>75</u>	<u>84</u>

WELL LOCATION:
 sec. 8 T22 NW R. 3 E
1 1/2 miles S-W of Drew, Mo
 (distance) (direction) (nearest town)

WELL PURPOSE: Home
 (home, irrigation, municipal, industrial)

- WELL COMPLETION DATA:
- (1) diameter (inches) 4"
 - (2) total depth (feet) 84
 - (3) static water level (feet) 15 ^{below} above top of ground.
 - (4) casing PVC 84
 (material) (depth)
 (size) If telescope see back.
 - (5) screen 10' 74
 (length) (depth to top)
4" PVC
 (size) (material)
 - (6) pump 1/2 10
 (HP) (yield gpm)
 (type power)
 - (7) electric log
 (yes or no)
 (organization running log)
 - (8) how well bottom plugged PVC Cap

DEPT. OF NATURAL RESOURCES
 BUREAU OF LAND & WATER RESOURCES


AUG 11 1982

RECEIVED

DRILLERS REMARKS:

If well telescopes please sketch and show depths.

GROUND LEVEL

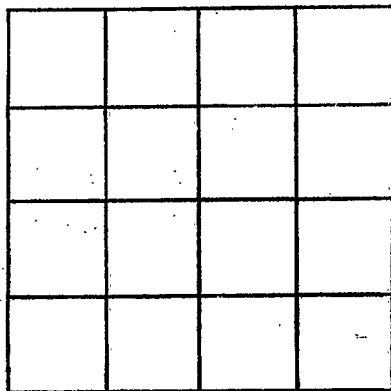

SECTION _____

Please indicate well location X.

ADDITIONAL INFORMATION

If more than one screen,
show locations of each on sketch.