

SUNF. MISSISSIPPI BOARD OF WATER COMMISSIONERS

G12
9-28-65

WATER WELL DRILLERS LOG

CODED

Date: 9/28, 1965, Drillers Fultonville Supply County Sumner
(Name)

(1) Owner of Land: C. V. Head
(Name)
R. F. D. Cleveland
(Address)

(2) Location: 1/4, 1/4, Sec. 5 21 R7,
5 miles to East, of Cleveland
(distance) (direction) (Nearest Town)

(3) Topography: ✓
(Hilly) (Flat) (Level)

(4) Purpose of Well: Domestic
(Domestic Irrigation
Municipal, Industrial, Other)

Description & Color of Materials Sand, Clay, Red Clay, Shell, etc.	Thick- ness Feet	Depth Feet
<u>Sand & clay</u>	<u>145</u>	
<u>sand & gravel</u>	<u>89</u>	<u>134</u>
<u>Rock</u>	<u>3</u>	<u>137</u>
<u>sand</u>	<u>7</u>	<u>144</u>
<u>clay</u>	<u>10</u>	<u>154</u>
<u>sand</u>	<u>11</u>	<u>165</u>
<u>Rock</u>	<u>1</u>	<u>166</u>
<u>clay</u>	<u>49</u>	<u>255</u>
<u>sand</u>	<u>50</u>	<u>305</u>
<u>clay</u>	<u>330</u>	<u>635</u>
<u>sand</u>	<u>65</u>	<u>700</u>
<u>clay</u>		

Information upon completion of well:

(1) Diameter 4 1/2 inches.

(2) Total Depth 692 feet.


(3) Water Level 23 feet below top of ground.

(4) Cased to _____, Size _____.

(5) Screen: Size 2, Length 20 ft.

(6) Were any formations sealed against pollution?
_____ yes, _____ no.

CODED

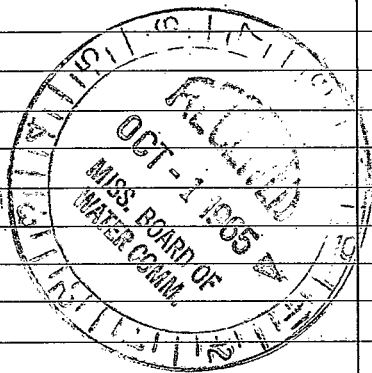

If YES depth of formation _____
Why _____

Drillers Remarks: _____

Yield in G. P. M.: 30

Type power: 1-HP pump & elec.

Crops irrigated & Acreage: _____

(Use Back Side)

Well No.

