

SUNFLOWER

G 13

5-3-71

MISSISSIPPI
 BOARD OF WATER COMMISSIONERS
 416 North State Street
 Jackson, Mississippi 39201

CODED

WATER WELL DRILLERS LOG
 BUTANE GAS CO. OF GREENWOOD

5-3-71
 date well completed

POST OFFICE BOX 1135
 GREENWOOD, MISS. 38930
 firm name

Sunflower
 county well located

LANDOWNER:	description of formations encountered	from	to
R. T. SCHIENER			
RT1 Box 164 Boyle (mailing address)	SAND	23	63
WELL LOCATION:	SAND + GRAVEL	63	169
sec. 29 T. 21 N R. 4 E	Clay	169	189
1 1/2 miles S of LINN	Rock	189	190
(distance) (direction) (nearest town)	Clay	190	215
WELL PURPOSE: Home	Rock	215	216
(home, irrigation, municipal, industrial)	Shale	216	321
WELL COMPLETION DATA:	SAND + SHALE	321	487
(1) diameter (inches) 4 X 2	Gummy Shale	487	654
(2) total depth (feet) 1459	SANDY SHALE	654	668
(3) static water level (feet) 20 below above top of ground.	SAND	668	730
(4) casing Steel 1429 (material) (depth)	SHALE	730	876
4 X 2 if telescope see back. (size)	Rock	876	877
(5) screen 30 1429 (length) (depth to top)	SHALE + Rock	877	1115
2" Stainless Steel (size) (material)	Rock	1115	1116
(6) pump 1 20 (HP) (yield gpm)	SHALE	1116	1120
Elcc (type power)	Rock	1120	1121
(7) electric log NO (yes or no)	SHALE	1121	1128
(organization running log)	Rock	1128	1129
(8) how well bottom plugged Lead Plug	SHALE + Rock	1129	1191
DRILLERS REMARKS: W G	SAND + SHALE	1191	1303
	SAND	1303	1379
	SHALE	1379	1385
	Rock	1385	1386
	SAND	1386	1465

MAY 14 1971
 MAY 14 1971

REC. ED. OF
 WATER COM.

If well telescopes please sketch and show depths.


GROUND LEVEL

105' 4" CASING →

1' 4" x 2" SWAGE
NIPPLE →

1323' 2" CASING →

30' 2" SCREEN →

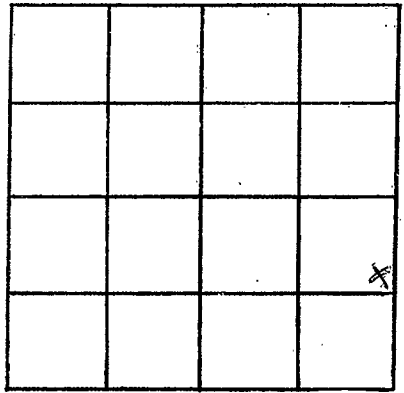

SECTION 29

Please indicate well location X.

ADDITIONAL INFORMATION

Lined area for additional information.

If more than one screen, show locations of each on sketch.