

SUNFLOWER

G 12 15

5-22-71

MISSISSIPPI BOARD OF WATER COMMISSIONERS 416 North State Street Jackson, Mississippi 39201

WATER WELL DRILLERS LOG

CODED

5/22

date well completed

1971 Duttarwell & Supply Co Sunflower

firm name

county/well located

LANDOWNER:

Billie W. Jones RFD 2 Cleveland (mailing address)

description of formations encountered

from

to

Table with 3 columns: description of formations encountered, from, to. Rows include: Sand, Limestone, Sand & gravel, Clay & shale, Sand, Limestone & shale, Sand, Shale & sand, n. p. Rock, Clay - shale & sand, Sand & shell, Shale.

WELL LOCATION:

sec. 6 T 21 N R 4 E (distance) miles 3/4 (direction) of Broussard (nearest town)

WELL PURPOSE: (home, irrigation, municipal, industrial)

WELL COMPLETION DATA:

- (1) diameter (inches) 4 1/2
(2) total depth (feet) 788
(3) static water level (feet) 216 below top of ground
(4) casing galv. pipe (material) 2 (size) 2 S.S. (depth)
(5) screen 20 (length) 20 (depth to top) 2 (size) S.S. (material)
(6) pump 1 (HP) 20 (yield gpm) 5/16 (type power)
(7) electric log 200c (yes or no)

CODED

JUN 11 1971

(organization running log)

(8) how well bottom plugged B.P. Collier


MISSISSIPPI BOARD OF WATER COMMISSIONERS SUPERVISOR GENERAL

DRILLERS REMARKS:

L. Ruffalo

If well telescopes please sketch and show depths.

GROUND LEVEL

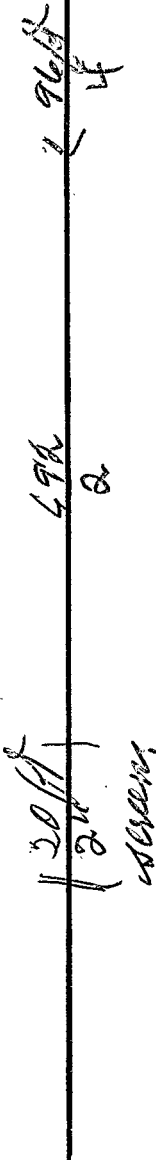

x			
		x	

SECTION 4

Please indicate well location X.

ADDITIONAL INFORMATION

If more than one screen, show locations of each on sketch.