

WATER WELL DRILLERS LOG

SUNFLOWER  
**CODED**

G 16  
11-9-64  
Date: 11/9, 1964, Driller: Bailey Mfg Co. (Name)

(1) Owner of Land: Ray Gentry  
 (Name)  
Linn, Miss  
 (Address)  
 (2) Location:  $\frac{1}{4}$ , 21 21N 4W, Sec. T R  
at Linn  
 (distance) miles (direction) of (Nearest Town)  
 (3) Topography: Flat  
 (Hilly) (Flat) (Level)  
 (4) Purpose of Well: Domestic  
 (Domestic Irrigation, Municipal, Industrial, Other)

| Description & Color of Materials<br>Sand, Clay, Red Clay, Shell, etc. | Thick-<br>ness<br>Feet | Depth<br>Feet |
|---|------------------------|---------------|
| Clay  |                        | 18            |
| Sand  |                        | 75            |
| Gravel  |                        | 130           |
| Mud   |                        | 215           |
| Sand  |                        | 392           |
| Mud   |                        | 420           |
| Sand  |                        | 447           |
| Mud   |                        | 525           |
| Sand  |                        | 561           |
| Sand, mud + rocks   |                        | 1063          |
| Sand  |                        | 1095          |


Information upon completion of well:

(1) Diameter 4 X 2 inches.  
 (2) Total Depth 1095 feet.  
 (3) Water Level 4 ft above feet below top of ground.  
 (4) Cased to all way, Size 4 X 2  
 (5) Screen: Size 2, Length 16 ft  
 (6) Were any formations sealed against pollution?  
 \_\_\_\_\_ yes, X no.

**CODED**

If YES depth of formation \_\_\_\_\_  
 Why \_\_\_\_\_

Drillers Remarks: \_\_\_\_\_  
 \_\_\_\_\_  
 \_\_\_\_\_

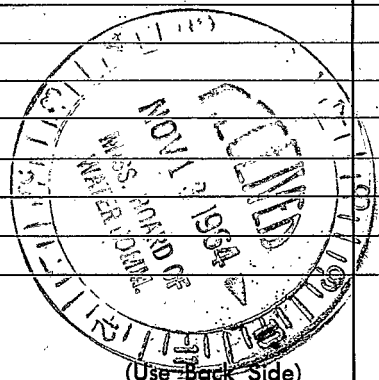

(Use Back Side)

Well No.

168  
852  
1020  
1030  
1050

Jelly Ridge planting  
Robinson Bur - Oct 64

Simplon or wash