

SunFlower
G17
3-10-72

MISSISSIPPI
 BOARD OF WATER COMMISSIONERS
 416 North State Street
 Jackson, Mississippi 39201

MAR 27 1972

WATER WELL DRILLERS LOG

3/10/72
 date well completed

BUTANE GAS CO. OF GREENWOOD
 firm name

Sunflower
 county well located

LANDOWNER:	description of formations encountered	from	to
C. N. Walker			
Staw, Miss. (mailing address)	CLAY	0	16
	SAND	16	45
	SAND + GRAVEL	45	116
WELL LOCATION:	SAND	116	250
sec. 7 T. 21 N R. 4 E W	CLAY	250	295
5 miles SW of Ruleville (distance) (direction) (nearest town)	SAND	295	415
	CLAY	415	505
WELL PURPOSE:	SAND	505	555
(home, irrigation, municipal, industrial)	CLAY	555	580
	SAND	580	675
WELL COMPLETION DATA:	CLAY	675	730
(1) diameter (inches) 4K	SAND	730	795
(2) total depth (feet) 1448	CLAY	795	935
(3) static water level (feet) 15 below top of ground.	SAND + Shale	935	1200
(4) casing Steel, 1428 (material), (depth)	CLAY	1200	1245
4K (size) if telescope see back.	SAND + Shale	1245	1275
(5) screen 20 (length), 1428 (depth to top)	CLAY	1275	1360
2 (size), Stainless (material)	SAND	1360	1460
(6) pump 1 (HP), 30 (yield gpm)			
Elec (type power)			
(7) electric log NO (yes or no)			
(organization running log)			
(8) how well bottom plugged BACK PRESSURE VALVE			
DRILLERS REMARKS:			

If well telescopes please sketch and show depths.

GROUND LEVEL


105' - 4" CASING →

1718' - 2" CASING →
105

1523'

20' - 2" SCREEN →

If more than one screen, show locations of each on sketch.

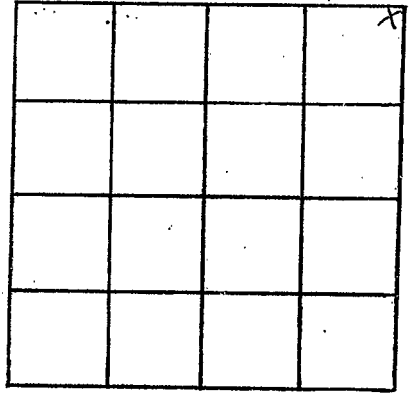

SECTION 7

Please indicate well location X.

ADDITIONAL INFORMATION

Multiple horizontal lines for additional information.