

**SUNFLOWER**  
**G 23**  
**3-27-75**

MISSISSIPPI  
 BOARD OF WATER COMMISSIONERS  
 416 North State Street  
 Jackson, Mississippi 39201

CODED

WATER WELL DRILLERS LOG

BUTANE GAS CO. OF GREENWOOD

3/27/75 19 date well completed  
 BUTANE GAS CO. OF GREENWOOD firm name  
 Sunflower county well located

LANDOWNER:  
 Sturdivant + Bishop  
 Ruleville  
 (mailing address)

description of formations encountered	from	to
	Clay	0
Sand + Gravel	30	40
Clay	40	60
Clay - Sand - Gravel	60	70
Sand + Gravel	70	113

WELL LOCATION:  
 sec. 1 T. 21 N. R. 4 E. W. 5  
1 miles SW of Ruleville  
 (distance) (direction) (nearest town)

WELL PURPOSE: FRN  
 (home, irrigation, municipal, industrial)

CODED

- WELL COMPLETION DATA:
- (1) diameter (inches) 16
  - (2) total depth (feet) 113
  - (3) static water level (feet) 15 below above top of ground.
  - (4) casing Steel, 73,  
 (material) (depth)  
16 If telescope see back.  
 (size)
  - (5) screen 40, 73  
 (length) (depth to top)  
16", Steel  
 (size) (material)
  - (6) pump 50, 2000  
 (HP) (yield gpm)  
Diesel  
 (type power)
  - (7) electric log NO  
 (yes or no)

(organization running log)

(8) how well bottom plugged  
Steel Plate


DRILLERS REMARKS:

RECEIVED  
 APR - 2 1975

MISS. BD. OF WATER COMMISSIONERS

If well telescopes please sketch and show depths.

GROUND LEVEL

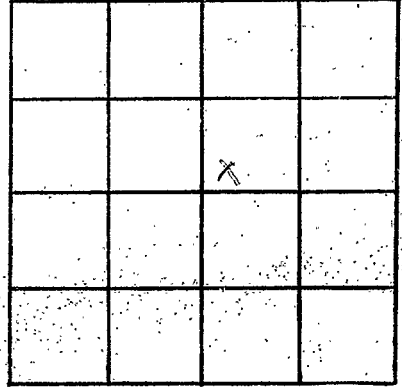

SECTION   1  

Please indicate well location X.

ADDITIONAL INFORMATION

If more than one screen, show locations of each on sketch.