

SUNFLOWER
 G 24
 3-28-75

MISSISSIPPI
 BOARD OF WATER COMMISSIONERS
 416 North State Street
 Jackson, Mississippi 39201

CODED

WATER WELL DRILLERS LOG

ENTANE GAS CO. OF GREENWOOD

SUNFLOWER

3/28/75 19 date well completed firm name county well located

LANDOWNER:
 STURDIVANT + Bishop
 Ruleville, Miss
 (mailing address)

description of formations encountered	from	to
CLAY	0	30
SAND + GRAVEL	30	100

WELL LOCATION:
 sec. 1 T 21 N R 4 E
 S W
 2 miles SW of Ruleville
 (distance) (direction) (nearest town)

WELL PURPOSE: TERR
 (home, irrigation, municipal, industrial)

CODED

- WELL COMPLETION DATA:
- (1) diameter (inches) 16"
 - (2) total depth (feet) 100
 - (3) static water level (feet) 16 below above top of ground.
 - (4) casing Steel 60'
 (material) (depth)
16" if telescope see back.
 (size)
 - (5) screen 40' 60'
 (length) (depth to top)
16" Steel
 (size) (material)
 - (6) pump 40 1800
 (HP) (yield gpm)
 - LP GAS
 (type power)
 - (7) electric log No
 (yes or no)

(organization running log)

(8) how well bottom plugged
Steel Plate


DRILLERS REMARKS:

RECEIVED
 APR - 2 1975

MISS. BD. OF WATER COMMISSIONERS

If well telescopes please sketch and show depths.

GROUND LEVEL

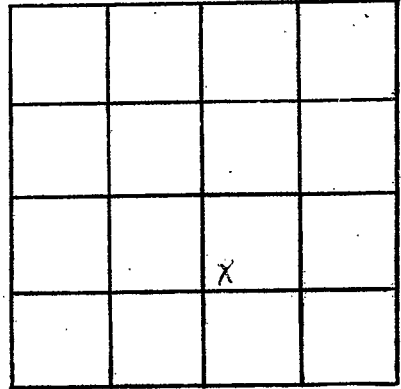

SECTION 1

Please indicate well location X.

ADDITIONAL INFORMATION

If more than one screen, show locations of each on sketch.