

**SUNFLOWER**  
**625**  
**3-20-75**

MISSISSIPPI  
 BOARD OF WATER COMMISSIONERS  
 416 North State Street  
 Jackson, Mississippi 39201

**WATER WELL DRILLERS LOG CODED**

3/20/75 19 **BUTANE GAS CO. OF GREENWOOD** *Sunflower*  
 date well completed firm name county well located

LANDOWNER:  
**ARTHUR CLARK III**  
**INDIANOLA**  
 (mailing address)

WELL LOCATION:  
 sec. 26 T. 21 N. R. 4 E. W.  
3 1/2 miles SE of Lynn  
 (distance) (direction) (nearest town)

WELL PURPOSE: FAK  
 (home, irrigation, municipal, industrial)

- WELL COMPLETION DATA:
- (1) diameter (inches) 16"
  - (2) total depth (feet) 112
  - (3) static water level (feet) 16 below above top of ground.
  - (4) casing Steel, 72,  
 (material) (depth)  
16 if telescope see back.  
 (size)
  - (5) screen 40', 72  
 (length) (depth to top)  
16", Steel  
 (size) (material)
  - (6) pump 60, 3000  
 (HP) (yield gpm)  
Diesel  
 (type power)
  - (7) electric log no  
 (yes or no)
- (organization running log)
- (8) how well bottom plugged Steel plate

| description of formations encountered | from | to  |
|---------------------------------------|------|-----|
| Clay                                  | 0    | 10  |
| Sand & Clay                           | 10   | 20  |
| Blue Clay                             | 20   | 30  |
| Clay                                  | 30   | 50  |
| Fine Sand                             | 50   | 80  |
| GRAVEL                                | 80   | 85  |
| Fine Sand                             | 85   | 90  |
| GRAVEL                                | 90   | 100 |
| SAND & GRAVEL                         | 100  | 112 |
| Clay                                  | 112  | 120 |

**CODED**


**REGISTERED**  
**APR 2 1975**

MISS. Bd. of WATER COMMISSIONERS

DRILLERS REMARKS:

If well telescopes please sketch and show depths.

GROUND LEVEL

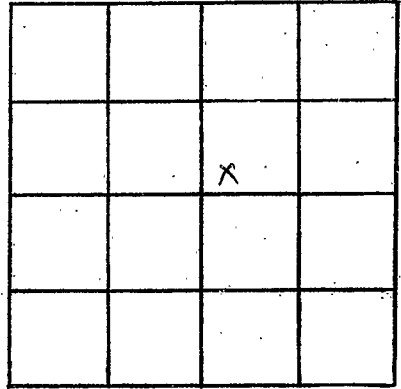

SECTION 26

Please indicate well location X.

ADDITIONAL INFORMATION

If more than one screen, show locations of each on sketch.