

**SUNFLOWER**  
**G 27**  
**4-21-75**

MISSISSIPPI  
 BOARD OF WATER COMMISSIONERS  
 416 North State Street  
 Jackson, Mississippi 39201

**CODED**

**WATER WELL DRILLERS LOG**

4/21 1975 *Duff Smith & Lubbock Sunflower*  
 (date well completed) firm name county well located

LANDOWNER:  
*Geo. Lindle*  
*Rt. Cleveland*  
 (mailing address)

description of formations encountered	from	to
<i>top soil</i>	<i>0</i>	<i>32</i>
<i>dark sand</i>	<i>32</i>	<i>49</i>
<i>Sand</i>	<i>49</i>	<i>65</i>
<i>cl &amp; gravel</i>	<i>65</i>	<i>115</i>

WELL LOCATION:  
 sec. *7* T. *21* N. R. *4* E  
*3* miles *S* of *Boyle*  
 (distance) (direction) (nearest town)

*Bottom on clay*

WELL PURPOSE: *irrigation*  
 (home, irrigation, municipal, industrial)

- WELL COMPLETION DATA:
- (1) diameter (inches) 12
  - (2) total depth (feet) 115
  - (3) static water level (feet) 22 below top of ground.
  - (4) casing steel (material) (depth) 12 if telescope see back. (size)
  - (5) screen 36 in (length) (depth to top) 12 in (size) steel (material)
  - (6) pump HP (HP) 1800 (yield gpm)  
Direct (type power)
  - (7) electric log no (yes or no)
  - (8) how well bottom plugged steel plate

DRILLERS REMARKS:

**CODED**


**RECEIVED**

APR 29 1975

MISS. BD. OF WATER COMMISSIONERS

If well telescopes please sketch and show depths.

GROUND LEVEL

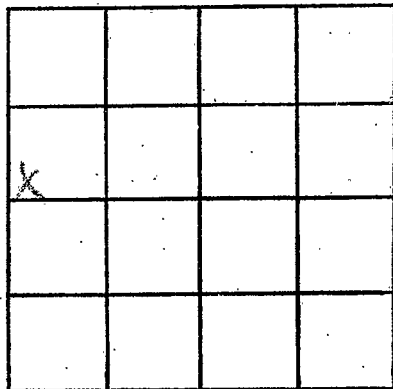

SECTION 7

Please indicate well location X.

ADDITIONAL INFORMATION

If more than one screen,  
show locations of each on sketch.