

SUNFLOWER
 531
 2/14/78

MISSISSIPPI
 BOARD OF WATER COMMISSIONERS
 416 North State Street
 Jackson, Mississippi 39201

CODED

WATER WELL DRILLERS LOG

2-14 1978 Layne Central Co. Sunflower
 date well completed firm name county well located

LANDOWNER: W.E. Jeffcoat
 Doddsville, MS

description of formations encountered	from	to
	Clay	0
Fine Sand	15	50
Coarse Sand	50	65
C. Sand & Gravel	65	110
Boulders	110	112

(mailing address)

WELL LOCATION:
 sec. 30 T 21 N R. 4 E
 6 miles W Doddsville
 (distance) (direction) (nearest town)

WELL PURPOSE: Irrigation
 (home, irrigation, municipal, industrial)

WELL COMPLETION DATA:

(1) diameter (inches) 16"
 (2) total depth (feet) 112'
 (3) static water level (feet) 19' below top of ground.
 (4) casing Steel 62' (material), (depth), 16" (size) If telescope see back.
 (5) screen 50' 62' (length), (depth to top) 16" St. Steel (size), (material)
 (6) pump 60 2800 (HP), (yield gpm) diesel (type power)
 (7) electric log No (yes or no)
 (organization running log)
 (8) how well bottom plugged St. Plate

CODED


RECEIVED
 MAR 14 1978

DRILLERS REMARKS:

MISS. BD. OF WATER COMMISSIONERS

If well telescopes please sketch and show depths.

GROUND LEVEL

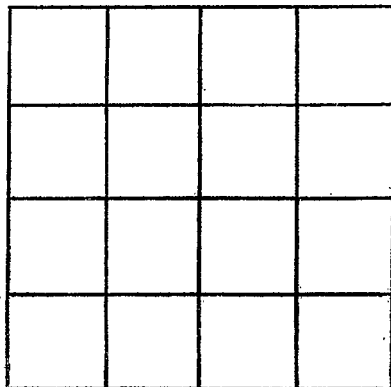

SECTION _____

Please indicate well location X.

ADDITIONAL INFORMATION

If more than one screen, show locations of each on sketch.