

SUNFLOWER

533

2/7/78

MISSISSIPPI BOARD OF WATER COMMISSIONERS 416 North State Street Jackson, Mississippi 39201

CODED

WATER WELL DRILLERS LOG

2-7-

date well completed

1978 Delta Well Supply Sunflower

firm name

county well located

LANDOWNER:

M.H. Walker

Cleveland Miss (mailing address)

WELL LOCATION:

sec. 4 T 21 N R 4 E W

1/4 miles W of Ruleville (distance) (direction) (nearest town)

WELL PURPOSE: Irrigation (home, irrigation, municipal, industrial)

WELL COMPLETION DATA:

- (1) diameter (inches) 10"
(2) total depth (feet) 96'
(3) static water level (feet) 30 below above top of ground.
(4) casing Steel (material) (depth) 10" (size) If telescope see back.
(5) screen 20 (length) (depth to top) 12" (size) (material)
(6) pump 20 (HP) 800 (yield gpm) Elec (type power)
(7) electric log No (yes or no)
(8) how well bottom plugged Steel plate

description of formations encountered

from

to



Table with 3 columns: description of formations encountered, from, to. Rows include Top soil, Clay, fine sand, Clay, sand (fine), coarse sand, clay, Shale & Rock, and Sit at.

RECEIVED MAR 27 1978 MISS. DD. OF WATER COMMISSIONERS

DRILLERS REMARKS:

If well telescopes please sketch and show depths.

GROUND LEVEL

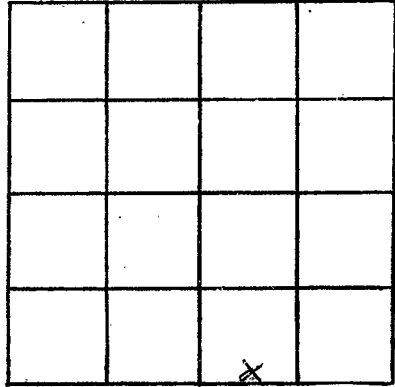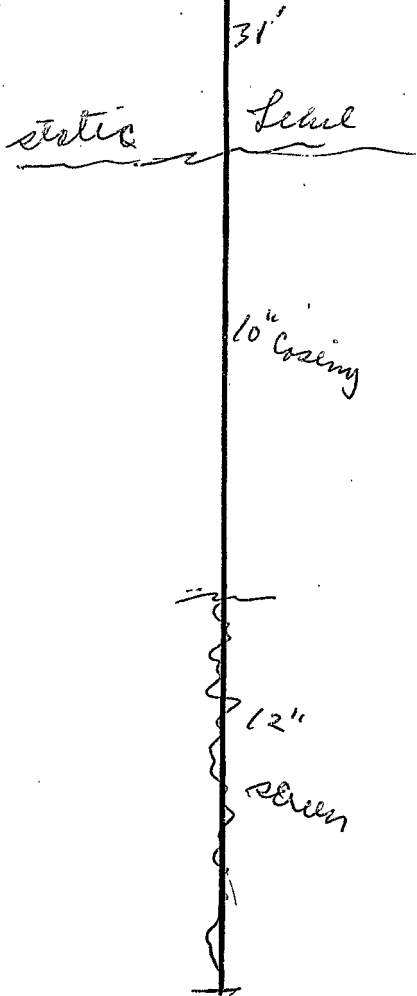

SECTION 1/2

Please indicate well location X.

ADDITIONAL INFORMATION

Lined area for additional information.

If more than one screen, show locations of each on sketch.