

SUNFLOWER
 CL-0786
 B 35
 3-12-78

MISSISSIPPI
 BOARD OF WATER COMMISSIONERS
 416 North State Street
 Jackson, Mississippi 39201

CODED

WATER WELL DRILLERS LOG

3-12 1978 LAYNE CENTRAL SUNFLOWER
 date well completed firm name county well located


LANDOWNER:	description of fomations encountered	from	to
Sunflower Enterprises			
Doddsville, MS (mailing address)	Coarse Red Sand	10	35
WELL LOCATION:	Coarse Sand	35	40
sec. 31 T 21 N R 4 W	Coarse Sand & Pea Gr.	40	52
3 miles W of Doddsville	Coarse Sand	52	75
(distance) (direction) (nearest town)	Coarse Sand & Pea Gr.	75	86
WELL PURPOSE: Irrigation	Coarse Sand & Gr.	86	110
(home, irrigation, municipal, industrial)	Coarse Sand & Big Gr	110	117
WELL COMPLETION DATA:			
(1) diameter (inches) 16"			
(2) total depth (feet) 117'			
(3) static water level (feet) 25 below top of ground.			
(4) casing Steel 67 (material) (depth)			
16 (size) if telescope see back.			
(5) screen 50' 67' (length) (depth to top)			
16" St. Steel (size) (material)			
(6) pump 60 2600 (HP) (yield gpm)			
diesel (type power)			
(7) electric log (yes or no)			
(organization running log)			
St. Plate			
(8) how well bottom plugged			
DRILLERS REMARKS:			

RECEIVED
 ALL
 OCT 5 1978

MISS. BD OF WATER COMM

If well telescopes please sketch and show depths.

GROUND LEVEL

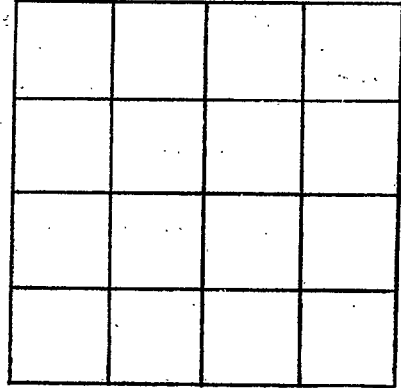

SECTION _____

Please indicate well location X.

ADDITIONAL INFORMATION

If more than one screen, show locations of each on sketch.