

SUNFLOWER
 537
 5/6/79

MISSISSIPPI
 BOARD OF WATER COMMISSIONERS CODED
 416 North State Street
 Jackson, Mississippi 39201
 WATER WELL DRILLERS LOG

5-6-79 date well completed 1979 Delta Well & Supply firm name Sunflower county well located

LANDOWNER: Helen Hines
 C. Cleveland Hines
 (mailing address)

| description of formations encountered | from | to |
|---------------------------------------|------|-----|
| Top soil | 0 | 16 |
| fine sand | 16 | 25 |
| Clay | 25 | 31 |
| Sand + Gravel | 31 | 121 |

WELL LOCATION:
 sec. 32 T. 21 N. R. 4 E
 8 S W
 3 miles W of Darks Mill
 (distance) (direction) (nearest town)

WELL PURPOSE: Irrigation
 (home, irrigation, municipal, industrial)

- WELL COMPLETION DATA:
- (1) diameter (inches) 12
 - (2) total depth (feet) 121
 - (3) static water level (feet) 39 below top of ground.
 - (4) casing Steel (material), (depth),
 12" (size) if telescope see back.
 - (5) screen 36' (length), (depth to top)
 12" (size), Steel (material)
 - (6) pump 56 (HP), 1300 (yield gpm)
Diesel (type power)
 - (7) electric log no (yes or no)
 - (organization running log)
 - (8) how well bottom plugged Steel Plate

CODED

Miss. Board of Water Comm.


JUN 13 1979

RECEIVED

DRILLERS REMARKS:

If well telescopes please sketch and show depths.

GROUND LEVEL

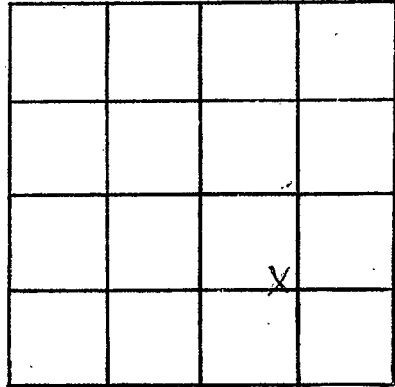

SECTION 22

Please indicate well location X.

ADDITIONAL INFORMATION

If more than one screen, show locations of each on sketch.