

MISSISSIPPI DEPARTMENT OF NATURAL RESOURCES

Bureau of Land and Water Resources

Southport Mall

P.O. Box 10631

Jackson, Mississippi 39201 **CODED**

WATER WELL DRILLERS LOG

SUNFLOWER
538
2/14/81

2-14 19 81 Delta Well Supply Sunflower
 date well completed firm name county well located

LANDOWNER:
Buck Braswell
Cleveland Miss.
 (mailing address)

description of formations encountered	from	to
	<u>Top soil</u>	<u>0</u>
<u>fine sand</u>	<u>12</u>	<u>18</u>
<u>Course sand</u>	<u>18</u>	<u>25</u>
<u>Course sand + Pea Gravel</u>	<u>25</u>	<u>115</u>
<u>art -</u>		<u>115</u>

WELL LOCATION:
 sec. 19T 21N R. 4E
6 1/2 miles SE of Cleveland
 (distance) (direction) (nearest town)

WELL PURPOSE: Irrigation
 (home, irrigation, municipal, industrial)

WELL COMPLETION DATA:

(1) diameter (inches) 16"

(2) total depth (feet) 115

(3) static water level (feet) 26 below above top of ground.

(4) casing Steel (material) (depth) _____
 _____ if telescope see back. (size)

(5) screen 40 75 (length) (depth to top)
16" Steel (size) (material)

(6) pump 60 2800 (HP) (yield gpm)
Diesel (type power)

(7) electric log no (yes or no)
 _____ (organization running log)

(8) how well bottom plugged Steel plate

DRILLERS REMARKS: _____

CODED

DEPT. OF NATURAL RESOURCES
 BUREAU OF LAND & WATER RESOURCES

MAR - 6 1981

RECEIVED

If well telescopes please sketch and show depths.

GROUND LEVEL


Water Level

26'

16" casing

40'

Screen

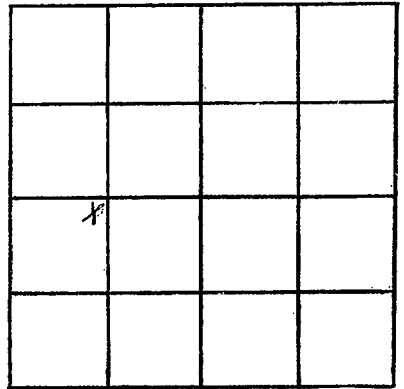

SECTION 19

Please indicate well location X.

ADDITIONAL INFORMATION

If more than one screen, show locations of each on sketch.