

MISSISSIPPI DEPARTMENT OF NATURAL RESOURCES

Bureau of Land and Water Resources

Southport Mall

P.O. Box 10631

Jackson, Mississippi 39201


WATER WELL DRILLERS LOG

SUNFLOWER
G 40
2-26-81

INDEXED

2-26-81 date well completed 1981 Delta Well Supply firm name Sunflower county well located

LANDOWNER:	description of formations encountered	from	to
Buck Boswell Cleveland miss. (mailing address)			
WELL LOCATION:			
sec. 19 T 21 N R 4 E 8 miles west of Dallsville (distance) (direction) (nearest town)			
WELL PURPOSE: Irrigation (home, irrigation, municipal, industrial)			
WELL COMPLETION DATA:			
(1) diameter (inches) 12"			
(2) total depth (feet) 116			
(3) static water level (feet) 25 below top of ground.			
(4) casing steel (material), (depth), (size) If telescope see back.			
(5) screen 40' (length), 76 (depth to top) 12" (size), steel (material)			
(6) pump 30 (HP), 1650 (yield gpm) Diesel (type power)			
(7) electric log no (yes or no) (organization running log)			
(8) how well bottom plugged Steel Plate			
DRILLERS REMARKS:			

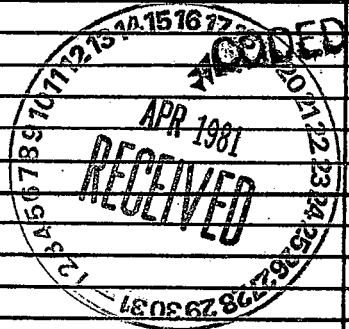


If well telescopes please sketch and show depths.

GROUND LEVEL

Static Level → 25'

12" casing

40' - 12" screen

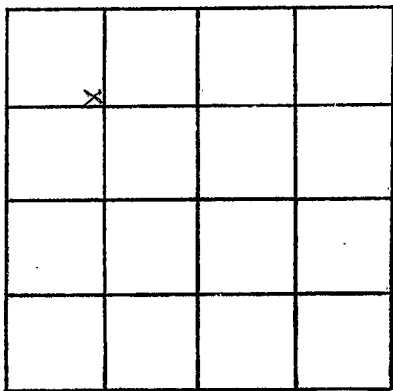

SECTION 19

Please indicate well location X.

ADDITIONAL INFORMATION

If more than one screen, show locations of each on sketch.