

MISSISSIPPI DEPARTMENT OF NATURAL RESOURCES

Bureau of Land and Water Resources

Southport Mall

P.O. Box 10631

Jackson, Mississippi 39209

WATER WELL DRILLERS LOG

Reviewed
8/81
Reviewed

Shelton
G42
6-17-81

GW 5006
IR/IR, Sec. 2
SE/NW?
Elev. 130

6-17-81 date well completed
19 *Dyer Well Drilling* firm name
Shelton county well located

LANDOWNER: *Billy Marlow*
RT1, Box 218
Ruleville, MS 38771
(mailing address)


description of formations encountered	from	to
<i>Clay</i>	<i>0</i>	<i>48</i>
<i>Fine Sand</i>	<i>44</i>	<i>56</i>
<i>Sand Gravel</i>	<i>54</i>	<i>113</i>

WELL LOCATION:
sec. 2 T 21 N R 4 E
S W
2 miles W of RULEVILLE
(distance) (direction) (nearest town)

WELL PURPOSE:
(home, irrigation, municipal, industrial)

- WELL COMPLETION DATA:
- (1) diameter (inches) 16
 - (2) total depth (feet) 113
 - (3) static water level (feet) 33 below above top of ground.
 - (4) casing Steel (material), (depth)
16 (size) If telescope see back.
 - (5) screen 40 (length), (depth to top)
16 (size) (material)
 - (6) pump 14 (HP), 3000 (yield gpm)
Diesel (type power)
 - (7) electric log No (yes or no)
 - (organization running log)
 - (8) how well bottom plugged Plate


CODED

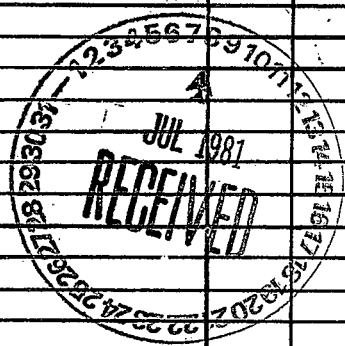

DRILLERS REMARKS:

If well telescopes please sketch and show depths.

GROUND LEVEL

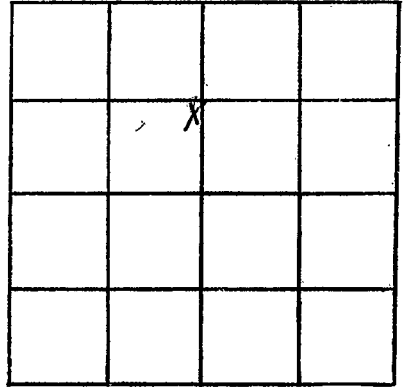

SECTION 2

Please indicate well location X.

ADDITIONAL INFORMATION

If more than one screen,
show locations of each on sketch.