

MISSISSIPPI DEPARTMENT OF NATURAL RESOURCES

Bureau of Land and Water Resources

Southport Mall

P.O. Box 10631

Jackson, Mississippi 39209

WATER WELL DRILLERS LOG

CODED

Sumflow
643
6-20-81

Gw 5009

IR/IR, Sec. 2

SE/NE?

Elev. 136

6/20/81 19 Reverell + Irrig Sumflow
date well completed firm name county well located

LANDOWNER: Billy Marlow
Route 1 Box 218
Reverell, Ms 38771
(mailing address)

description of formations encountered	from	to
<u>C lean</u>	<u>D</u>	<u>40</u>
<u>fine sand</u>	<u>40</u>	<u>46</u>
<u>sand + gravel</u>	<u>46</u>	<u>113</u>


WELL LOCATION:
sec. 2 T 21 S R 4 E
2 miles W of Reverine
(distance) (direction) (nearest town)

WELL PURPOSE:
(home, irrigation, municipal, industrial)

- WELL COMPLETION DATA:
- (1) diameter (inches) 16
 - (2) total depth (feet) _____
 - (3) static water level (feet) 23 below above top of ground.
 - (4) casing Steel
(material) (depth)
16 if telescope see back.
(size)
 - (5) screen 40
(length) (depth to top)
16
(size)
 - (6) pump 14 3000
(HP) (material) (yield gpm)
 - Reverell
(type power)
 - (7) electric log No
(yes or no)


(organization running log) Plate
(8) how well bottom plugged

DRILLERS REMARKS:

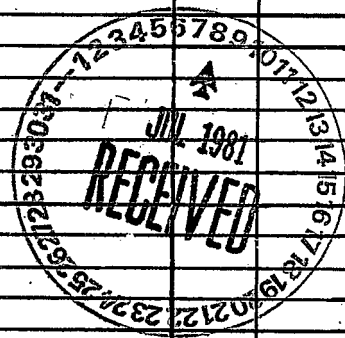

If well telescopes please sketch and show depths.

GROUND LEVEL

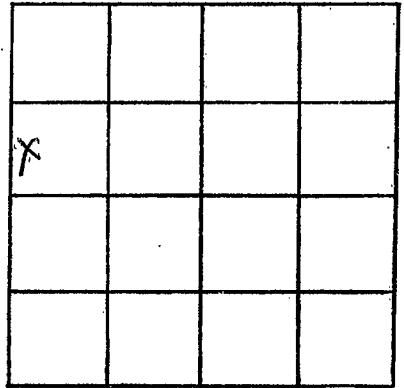

SECTION 2

Please indicate well location X.

ADDITIONAL INFORMATION

If more than one screen, show locations of each on sketch.