

**MISSISSIPPI DEPARTMENT OF NATURAL RESOURCES**  
**Bureau of Land and Water Resources**  
 Southport Mall  
 P.O. Box 10631  
 Jackson, Mississippi 39209 **CODED**  
**WATER WELL DRILLERS LOG**

Sunflower  
544  
CL-1759-2-23-81

2-23- 19 81 Layne-Central Company Sunflower  
 date well completed firm name county well located

LANDOWNER:	description of formations encountered	from	to
<u>Stanley Livingston</u>			
<u>Ruleville, MS</u>	<u>Fine sand</u>	<u>14</u>	<u>22</u>
(mailing address)	<u>Fine Sand</u>	<u>22</u>	<u>35</u>
	<u>Coarse sand PG</u>	<u>35</u>	<u>42</u>
	<u>Coarse sand &amp; Gravel</u>	<u>42</u>	<u>112</u>


**WELL LOCATION:**  
 ? sec 3 T 21N S R 4E  
1 miles (distance) 2 (direction) of Doakery (nearest town)

**WELL PURPOSE:** irrigation  
 (home, irrigation, municipal, industrial)

**WELL COMPLETION DATA:**

- (1) diameter (inches) 32"
- (2) total depth (feet) 112"
- (3) static water level (feet) 22" below top of ground.
- (4) casing Steel 60"  
 (material) (depth)  
16" if telescope see back.  
 (size)
- (5) screen 50" 62"  
 (length) (depth to top)  
16" Doerr  
 (size) (material)
- (6) pump 60 2500  
 (HP) (yield gpm)  
Diesel  
 (type power)
- (7) electric log no  
 (yes or no)  
none  
 (organization running log)
- (8) how well bottom plugged steel plated

**CODED**

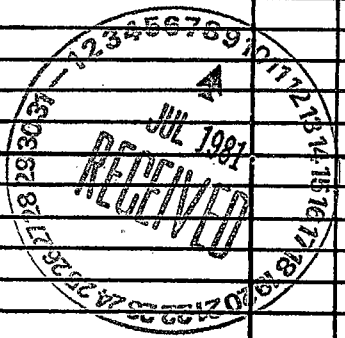

**DRILLERS REMARKS:**

If well telescopes please sketch and show depths.

GROUND LEVEL


SECTION \_\_\_\_\_

Please indicate well location X.

ADDITIONAL INFORMATION

If more than one screen,  
show locations of each on sketch.