

MISSISSIPPI DEPARTMENT OF NATURAL RESOURCES
 Bureau of Land and Water Resources
 Southport Mall
 P.O. Box 10631
 Jackson, Mississippi 39209
WATER WELL DRILLERS LOG

CODED

SUNFLOWER
G 45
8-3-81

8/3/81 19 Deep well org Sunflower
 date well completed firm name county well located

LANDOWNER: John Burrell
Pulleville, MS
 (mailing address)

description of formations encountered	from	to
Sam	13	23
Sam	23	33
Sam	33	43
sand gravel	43	53
gravel	53	63
gravel	63	73
sand gravel	73	83
gravel	83	93
sand gravel	93	103
gravel	103	113


WELL LOCATION:
 sec. 1 T R20 N 4 R 4 E
1 miles W of Pulleville
 (distance) (direction) (nearest town)

WELL PURPOSE:
 (home, irrigation, municipal, industrial)

WELL COMPLETION DATA:
 (1) diameter (inches) 16
 (2) total depth (feet) 113'
 (3) static water level (feet) 21 below above top of ground.
 (4) casing Steel (material) (depth) 16 if telescope see back. (size)
 (5) screen 40 73' (length) (depth to top) (size) Steel (material)
 (6) pump 40 2000 (HP) (yield gpm)
Electric (type power)
 (7) electric log no (yes or no)

(organization running log)
 (8) how well bottom plugged Plate

DRILLERS REMARKS:

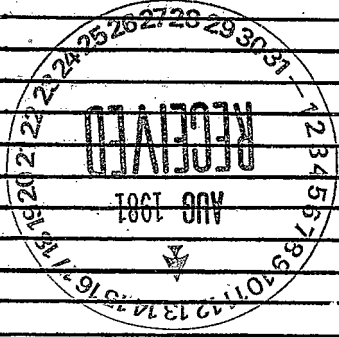

CODED

If well telescopes please sketch and show depths.

GROUND LEVEL

X			

SECTION /

Please indicate well location X.

ADDITIONAL INFORMATION

If more than one screen, show locations of each on sketch.