

CODED

MISSISSIPPI  
BOARD OF WATER COMMISSIONERS  
416 North State Street  
Jackson, Mississippi 39201

WATER WELL DRILLERS LOG

Sunflower  
G68  
6-5-69

6-5-1969 date well completed  
G. D. VERO WELL-DR. SER. firm name  
SUNFLOWER county well located

LANDOWNER: J. H. Stead  
R.R.

description of formations encountered	from	to
Clay	Top	20'
Sand	20'	55'
Sand & gravel	55'	170'
sand	170'	420'
Clay	420'	530'
Sand	530'	740'
Clay	740'	838'
Sand & gravel	838'	905'
Clay	905'	960'
Sand	960'	1180'

DODDSVILLE  
(mailing address)

WELL LOCATION:  
sec. 23 T. 21 N. R. 4 E.  
W  
4 miles WEST of DODDSVILLE  
(distance) (direction) (nearest town)

WELL PURPOSE: HOME  
(home, irrigation, municipal, industrial)

- WELL COMPLETION DATA:
- (1) diameter (inches) 4" x 2"
  - (2) total depth (feet) 1176'
  - (3) static water level (feet) Flow below top of ground
  - (4) casing 4" - 136 FT. (material) (depth)  
2" to 1156'  
(size) If telescope see back.
  - (5) screen 20 FT., 1156 FT. (length) (depth to top)  
2", STAINLESS STEEL (size) (material)
  - (6) pump 1 28 (HP) (yield gpm)  
ELEC. (type power)
  - (7) electric log No (yes or no)  
(organization running log)
  - (8) how well bottom plugged J.P. VADE


SEP 20 1969  
MISS. DEPT. OF WATER CONSERVATION

DRILLERS REMARKS:

If well telescopes please sketch and show depths.

GROUND LEVEL

4" DIRECT CONNECTED  
WITH 4x2 SWAGE  
2" SCREEN DIRECT  
CONNECTED

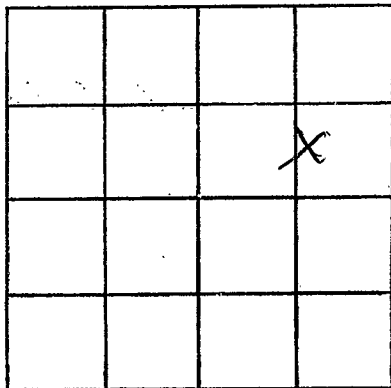

SECTION 23

Please indicate well location X.

ADDITIONAL INFORMATION

If more than one screen,  
show locations of each on sketch.