

SUNFLOWER

G 72

3-8-71

MISSISSIPPI BOARD OF WATER COMMISSIONERS

416 North State Street Jackson, Mississippi 39201

CODED

WATER WELL DRILLERS LOG

3/4 19 71 Datta Well Drilling Co Sunflower date well completed firm name county well located

LANDOWNER: James Striffen Johnson & Sons R.F.D. Cleveland (mailing address)

Table with 3 columns: description of formations encountered, from, to. Rows include: Top Soil, Sand & Gravel, Gravel, Blue Clay, Sand, Sand & shale, Sand, Clay & shale, Sand & Clay, Sand, Sand & Clay, Sand.

WELL LOCATION: sec 5 T 21 N R 4 E 5 miles West of Paducah (distance) (direction) (nearest town)

WELL PURPOSE: Normal (home, irrigation, municipal, industrial)

- WELL COMPLETION DATA: (1) diameter (inches) 4 x 2 1/2 (2) total depth (feet) 735 (3) static water level (feet) 27 below top of ground. (4) casing galv pipe (material) (depth) (size) if telescope see back. (5) screen 20 ft (length) (depth to top) 2" 3-8-Steel (size) (material) (6) pump 1 1/2 28 (HP) (yield gpm) 3 hp (type power) (7) electric log N/A (yes or no) (organization running log) (8) how well bottom plugged B.F. Valice

CODED



MAR 19 1971

MISS. BD. OF WATER COMM.

DRILLERS REMARKS: Andrew R. ...

If well telescopes please sketch and show depths.

GROUND LEVEL

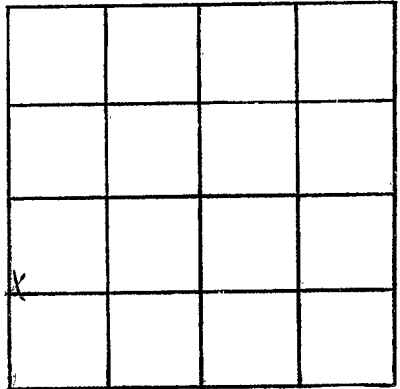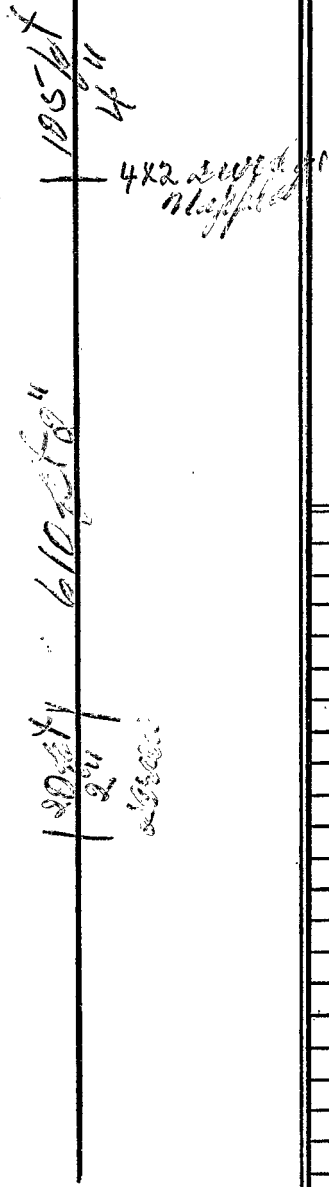

SECTION 5

Please indicate well location X.

ADDITIONAL INFORMATION

Lined area for additional information.

If more than one screen, show locations of each on sketch.