

Sunflower  
G 73  
6-67

MISSISSIPPI  
 BOARD OF WATER COMMISSIONERS  
 416 North State Street  
 Jackson, Mississippi 39201

WATER WELL DRILLERS LOG

6/23 1967 Delta Well & Supply, Sunflower  
 date well completed firm name county well located

LANDOWNER:

CR. Milton Smith  
Cleveland, Miss.  
 (mailing address)

description of formations encountered

from to

<u>Top Clay Sand</u>	<u>0</u>	<u>28</u>
<u>Fine Hard Sand</u>	<u>28</u>	<u>50</u>
<u>good Sand</u>	<u>30</u>	<u>75</u>
<u>Fine "</u>	<u>75</u>	<u>90</u>
<u>Sand &amp; gravel</u>	<u>90</u>	<u>155</u>

WELL LOCATION:


sec 6 T 21 N R 4 E  
3 miles to East of Cleveland  
 (distance) (direction) (nearest town)

WELL PURPOSE:

Domestic  
 (home, irrigation, municipal, industrial)

WELL COMPLETION DATA:


- (1) diameter (inches) 1 1/2
- (2) total depth (feet) 134-10"
- (3) static water level (feet) 27 below above top of ground.
- (4) casing Steel 96'  
 (material) (depth)  
 (size) if telescope see back.
- (5) screen 38 96'  
 (length) (depth to top)  
12 Steel  
 (size) (material)
- (6) pump 25 1600  
 (HP) (yield gpm)  
Elec.  
 (type power)
- (7) electric log No.  
 (yes or no)  
 (organization running log)
- (8) how well bottom plugged Concrete

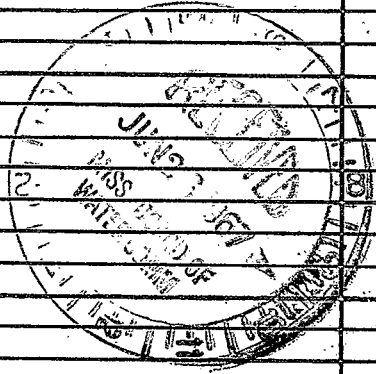

DRILLERS REMARKS:

If well telescopes please sketch and show depths.

GROUND LEVEL

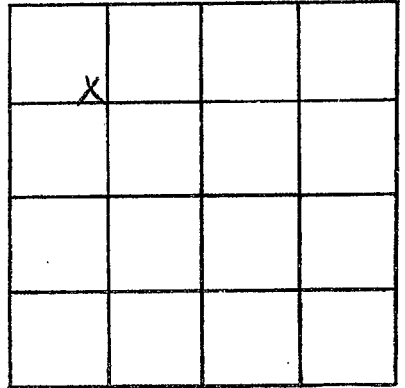

SECTION 6

Please indicate well location X.

ADDITIONAL INFORMATION

If more than one screen,  
show locations of each on sketch.