


SUNF. MISSISSIPPI BOARD OF WATER COMMISSIONERS

G 74
5-28-62

WATER WELL DRILLERS LOG

Date: MAY 28, 1962, Driller: DELTA DRILLING Co County SUNFLOWER
(Name)

	Description & Color of Materials Sand, Clay, Red Clay, Shell, etc.	Thick- ness Feet	Depth Feet
(1) Owner of Land: <u>FRED STAGGS</u> (Name)	<u>GUMBO</u>	<u>18</u>	<u>18</u>
<u>RTE. 1, Box 403, DODDSVILLE, MISS</u> (Address)	<u>SAND</u>	<u>68</u>	<u>86</u>
(2) Location: <u>S W 1/4, N W 1/4, Sec. 36</u> ^{30A} TOWN 41E <u>21 N</u>	<u>GRAVEL</u>	<u>59</u>	<u>145</u>
_____ miles _____, of _____ (distance) (direction) (Nearest Town)	<u>SAND</u>	<u>44</u>	<u>234</u>
(3) Topography: _____ (Hilly) (Flat) (Level)	<u>GUMBO</u>	<u>41</u>	<u>275</u>
(4) Purpose of Well: <u>DOMESTIC</u> (Domestic Irrigation Municipal, Industrial, Other)	<u>SHALE</u>	<u>25</u>	<u>300</u>
Information upon completion of well:	<u>SAND</u>	<u>70</u>	<u>370</u>
(1) Diameter <u>4</u> inches.	<u>SHALE</u>	<u>32</u>	<u>402</u>
(2) Total Depth <u>1122</u> feet.	<u>SAND</u>	<u>126</u>	<u>528</u>
(3) Water Level <u>WELL FLOWS</u> feet below top of ground.	<u>GUMBO</u>	<u>51</u>	<u>579</u>
(4) Cased to <u>1122'</u> , Size <u>4x2"</u>	<u>SHALE</u>	<u>61</u>	<u>640</u>
(5) Screen: Size <u>2"</u> , Length <u>63'</u> <u>PERFORATED PIPE</u>	<u>SAND</u>	<u>44</u>	<u>684</u>
(6) Were any formations sealed against pollution? _____ yes, _____ no.	<u>SHALE</u>	<u>102</u>	<u>786</u>
If YES depth of formation _____	<u>GUMBO</u>	<u>43</u>	<u>829</u>
Why _____	<u>SHALE</u>	<u>84</u>	<u>913</u>
Drillers Remarks: _____	<u>SAND W/9" ROCK</u>	<u>42</u>	<u>955</u>
_____	<u>SHALE</u>	<u>24</u>	<u>979</u>
_____	<u>SAND W/9" ROCK</u>	<u>72</u>	<u>1051</u>
_____	<u>SHALE</u>	<u>11</u>	<u>1062</u>
_____	<u>SAND</u>	<u>60</u>	<u>1122</u>

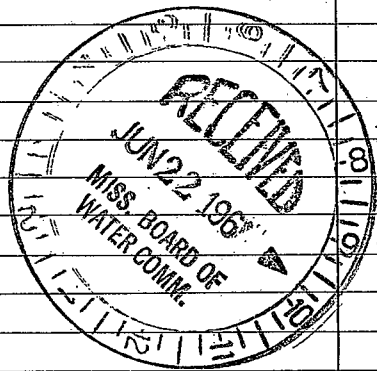

(Use Back Side)

Well No.

