

G 75  
5-27-63

WATER WELL DRILLERS LOG


Date: 5/27, 1963, Driller: Dr. J. H. Smith County: Jefferson  
(Name)

	Description & Color of Materials Sand, Clay, Red Clay, Shell, etc.	Thick- ness Feet	Depth Feet
(1) Owner of Land: <u>Dr. J. H. Smith</u> (Name) <u>Richardella, La. 70301</u> (Address)	Sand & clay	20	
(2) Location: <u>1/4</u> , <u>1/4</u> , Sec. <u>5</u> <u>DIREV</u> <u>6</u> miles <u>East</u> of <u>Smith</u> (distance) (direction) (Nearest Town)	Fine sand & clay	25	65
(3) Topography: _____ (Hilly) (Flat) (Level)	Fine sand & clay	12	77
(4) Purpose of Well: <u>Irrigation</u> (Domestic, Irrigation, Municipal, Industrial, Other)	Sand & gravel	40	117
	Rock	1	118
	Cracked gravel	19 1/2	137 1/2

Information upon completion of well:

- (1) Diameter 14 inches.
- (2) Total Depth 137 1/2 feet.
- (3) Water Level 22 feet below top of ground.
- (4) Cased to \_\_\_\_\_, Size \_\_\_\_\_
- (5) Screen: Size 14, Length 40
- (6) Were any formations sealed against pollution?  
\_\_\_\_\_ yes, \_\_\_\_\_ no.

If YES depth of formation \_\_\_\_\_  
Why \_\_\_\_\_  
Drillers Remarks: \_\_\_\_\_

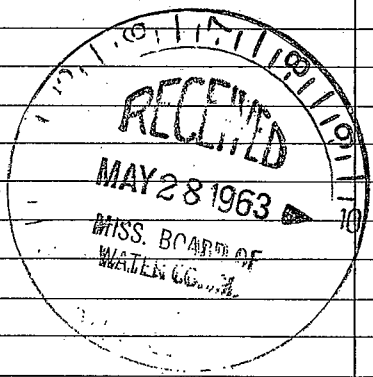

(Use Back Side)

Well No.

