

**MISSISSIPPI DEPARTMENT OF NATURAL RESOURCES**  
 Bureau of Land and Water Resources  
 Southport Mall  
 P.O. Box 10631  
 Jackson, Mississippi 39209  
**WATER WELL DRILLERS LOG**

**CODED**

G-76  
SUNFLOWER  
7-25-80

July 25 1980 Delta well Sunflower  
 date well completed firm name county/well located

**LANDOWNER:**  
Belen Minors  
Cleveland miss.  
 (mailing address)

| description of formations encountered | from | to  |
|---------------------------------------|------|-----|
| top soil                              | 0    | 17  |
| fine sand                             | 17   | 25  |
| Clay                                  | 25   | 58  |
| Coarse sand                           | 58   | 70  |
| Coarse sand - Bone                    | 70   | 117 |

**WELL LOCATION:**  
 sec. B T 21 N R 4 E  
6 miles SE of Cleveland  
 (distance) (direction) (nearest town)

**WELL PURPOSE:** Irrigation  
 (home, irrigation, municipal, industrial)

**CODED**

- WELL COMPLETION DATA:**
- (1) diameter (inches) 12
  - (2) total depth (feet) 117
  - (3) static water level (feet) 28 below above top of ground.
  - (4) casing Steel (material) (depth) \_\_\_\_\_ if telescope see back. (size)
  - (5) screen 40 (length) (depth to top) \_\_\_\_\_  
12" (size) Steel (material)
  - (6) pump 30 (HP) 1700 (yield gpm)  
2 P Nos (type power)
  - (7) electric log no (yes or no)  
 (organization running log) \_\_\_\_\_
  - (8) how well bottom plugged Steel Pipe

**DRILLERS REMARKS:**  
 \_\_\_\_\_  
 \_\_\_\_\_  
 \_\_\_\_\_

DEPT. OF NATURAL RESOURCES  
 BUREAU OF LAND & WATER RESOURCES

SEP 8 - 1980  
**RECEIVED**

If well telescopes please sketch and show depths.

GROUND LEVEL

*Static Level* →

28'


12"

*casing  
+  
steel*

60'

*screen*

12"

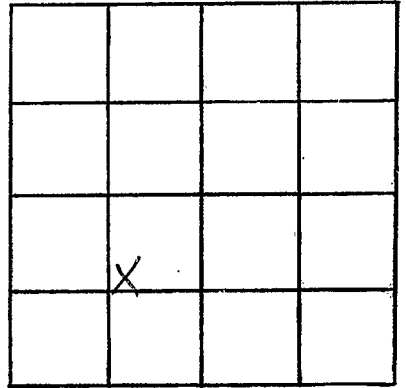

SECTION 7

Please indicate well location X.

ADDITIONAL INFORMATION

If more than one screen, show locations of each on sketch.