




If well telescopes please sketch and show depths.

GROUND LEVEL

Water Level 29.6'

16' casing

40' 4" screen

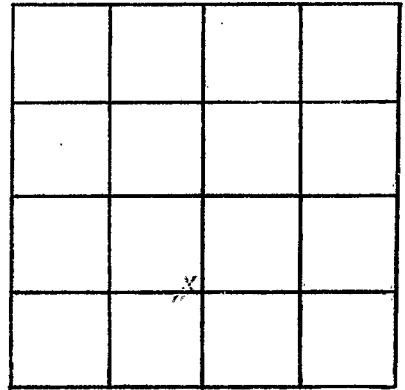

SECTION 1

Please indicate well location X.

ADDITIONAL INFORMATION

If more than one screen, show locations of each on sketch.