

MISSISSIPPI DEPARTMENT OF NATURAL RESOURCES

Bureau of Land and Water Resources

Southport Mall

P.O. Box 10631

Jackson, Mississippi 39209

WATER WELL DRILLERS LOG

CODED

Sunflower
G-80
4/11/83

Apr. 11 - 1983  
date well completed

Delta Well - Supply  
firm name

Sunflower  
county well located

LANDOWNER:	description of formations encountered	from	to
Stokely Farms Cleveland Miss (mailing address)			
	fine sand	25	73
	chance sand	73	95
	Coarse sand & gravel	95	118
WELL LOCATION:			
sec. <u>3</u> T. <u>21</u> N. R. <u>4</u> E. S W			
<u>3 1/2</u> miles <u>SW</u> of <u>Randall</u> (distance) (direction) (nearest town)			
WELL PURPOSE: <u>irrigation</u> (home, irrigation, municipal, industrial)			
WELL COMPLETION DATA:			
(1) diameter (inches) <u>12</u>			
(2) total depth (feet) <u>118</u>			
(3) static water level (feet) <u>31</u> below top of ground.			
(4) casing <u>Steel</u> (material) (depth)			
(size) if telescope see back.			
(5) screen <u>40'</u> (length) (depth to top)			
<u>12"</u> <u>Steel</u> (size) (material)			
(6) pump <u>40</u> <u>2200</u> (HP) (yield gpm)			
<u>Diesel</u> (type power)			
(7) electric log <u>no</u> (yes or no)			
(organization running log)			
(8) how well bottom plugged <u>Steel Plate</u>			

CODED

DEPT. OF NATURAL RESOURCES  
BUREAU OF LAND & WATER RESOURCES

MAY 23 1983

RECEIVED

DRILLERS REMARKS:

If well telescopes please sketch and show depths.


GROUND LEVEL

31' 6" 20' Tank

12" casing

40' 12" casing

If more than one screen, show locations of each on sketch.

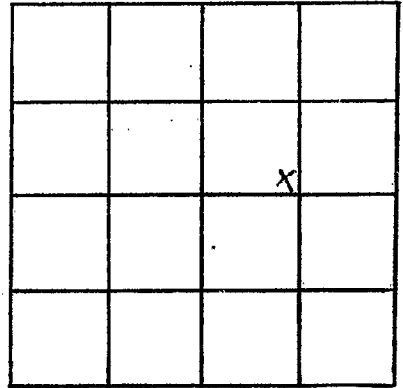

SECTION 3

Please indicate well location X.

ADDITIONAL INFORMATION

Lined area for additional information.