

MISSISSIPPI DEPARTMENT OF NATURAL RESOURCES

Bureau of Land and Water Resources

Southport Mall

P.O. Box 10631

Jackson, Mississippi 39209

WATER WELL DRILLERS LOG

G82
 CL-2127 Sunflower
 4-10-83

LAYNE CENTRAL CO.

CODED
 SUNFLOWER

4/10/83 19 date well completed
 LAYNE CENTRAL CO. firm name
 county well located

LANDOWNER:	description of formations encountered	depth	
		from	to
Eastland Plantation P.O. Box 6 Sunflower, MS 38736 (mailing address)	clay	0	46
	med. coarse sand	46	57
	coarse sand	57	64
	coarse sand & pea gra	64	86
	coarse sand gravel	86	123

WELL LOCATION:
 sec. 12 T 12 N R. 4 W
3 1/2 miles NW of Doddsville
 (distance) (direction) (nearest town)

WELL PURPOSE: Irrigation
 (home, irrigation, municipal, industrial)

WELL COMPLETION DATA:

(1) diameter (inches) 32"

(2) total depth (feet) 123'

(3) static water level (feet) 28' below above top of ground.

(4) casing steel 73'
 (material) (depth)
16" If telescope see back.
 (size)

(5) screen 50' 73'
 (length) (depth to top)
16" st. steel
 (size) (material)

(6) pump 60 1000
 (HP) (yield gpm)
diesel
 (type power)

(7) electric log no
 (yes or no)
 (organization running log)

st. plate

(8) how well bottom plugged

CODED

DEPT. OF NATURAL RESOURCES
 BUREAU OF LAND & WATER RESOURCES


OCT 10 1983

RECEIVED

DRILLERS REMARKS:

If well telescopes please sketch and show depths.

GROUND LEVEL

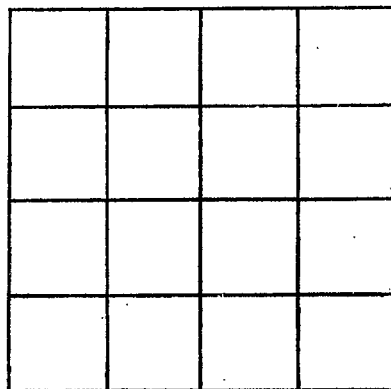

SECTION _____

Please indicate well location X.

ADDITIONAL INFORMATION

If more than one screen,
show locations of each on sketch.