

MISSISSIPPI DEPARTMENT OF NATURAL RESOURCES

Bureau of Land and Water Resources

Southport Mall

P.O. Box 10631

Jackson, Mississippi 39209

WATER WELL DRILLERS LOG

CODED

G83  
 CL-2312 Sunflower  
 3-30-83

3/30 19 83      LAYNE CENTRAL CO.      SUNFLOWER  
 date well completed      firm name      county well located

LANDOWNER:	description of formations encountered	from	to
EASTLAND PLANTATION	clay	0	26
DODDSVILLE, MS (mailing address)	blue clay	26	70
	coarse sand gravel	70	117
	clay	117	

WELL LOCATION:  
 sec. 18 T 21 N R 4 W  
 3 miles NW of Doddsville  
 (distance) (direction) (nearest town)

WELL PURPOSE: Irrigation  
 (home, irrigation, municipal, industrial)

WELL COMPLETION DATA:

(1) diameter (inches) 28"

(2) total depth (feet) 117'

(3) static water level (feet) 27' 10" below top of ground.

(4) casing steel 77' (material) (depth)  
 12" (size) if telescope see back.

(5) screen 40' 40' (length) (depth to top)  
 12" steel (size) (material)

(6) pump 60 1000 (HP) (yield gpm)  
 diesel (type power)

(7) electric log No (yes or no)  
 (organization running log)

(8) how well bottom plugged st. plate

CODED

DEPT. OF NATURAL RESOURCES  
 BUREAU OF LAND & WATER RESOURCES


OCT 10 1983

RECEIVED

DRILLERS REMARKS:

If well telescopes please sketch and show depths.

GROUND LEVEL

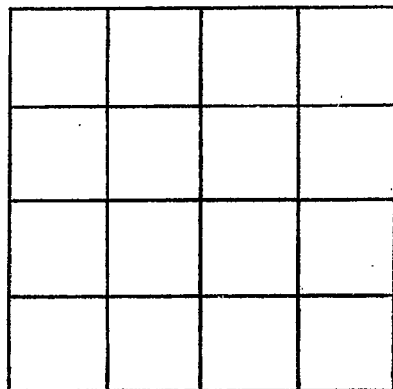

SECTION \_\_\_\_\_

Please indicate well location X.

ADDITIONAL INFORMATION

If more than one screen,  
show locations of each on sketch.