

MISSISSIPPI DEPARTMENT OF NATURAL RESOURCES
 Bureau of Land and Water Resources
 Southport Mall
 P.O. Box 10631
 Jackson, Mississippi 39209
WATER WELL DRILLERS LOG

SUNFLOWER
G 84

CODEL

May 10 1984 S. Flowers Sunflower
 date well completed firm name county well located

LANDOWNER:
Fisher Farm Service
A. Ludeen Harris
 (mailing address)

description of formations encountered	from	to
	<u>top</u>	<u>0</u>
<u>clay</u>	<u>14</u>	<u>20</u>
<u>sand & gravel</u>	<u>20</u>	<u>25</u>
<u>Coarse sand</u>	<u>25</u>	<u>121</u>

WELL LOCATION:
 sec. 7 T 21 N R. 4 E
6 miles S.E. of Cleveland
 (distance) (direction) (nearest town)

WELL PURPOSE: irrigation
 (home, irrigation, municipal, industrial)

- WELL COMPLETION DATA:**
- (1) diameter (inches) 16"
 - (2) total depth (feet) 121
 - (3) static water level (feet) 36 below top of ground.
 - (4) casing Steel (material), (depth)
14" (size) if telescope see back.
 - (5) screen 40 (length), (depth to top)
16" (size), Steel (material)
 - (6) pump 60 (HP), 3000 (yield gpm)
Diesel (type power)
 - (7) electric log no (yes or no)
 - (organization running log)
 - (8) how well bottom plugged steel plate

CODED

DEPT. OF NATURAL RESOURCES
 BUREAU OF LAND & WATER RESOURCES

MAY 2 1984

RECEIVED

DRILLERS REMARKS:

If well telescopes please sketch and show depths.


GROUND LEVEL

Well Case

36'

16" casing

12" cap

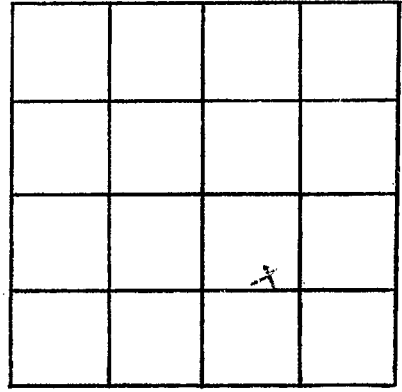

SECTION 7

Please indicate well location X.

ADDITIONAL INFORMATION

If more than one screen, show locations of each on sketch.