

MISSISSIPPI DEPARTMENT OF NATURAL RESOURCES
Bureau of Land and Water Resources
 Southport Mall
 P.O. Box 10631
 Jackson, Mississippi 39209
WATER WELL DRILLERS LOG

CODED

SUNFLOWER

CL-2607

G 85

3-24 19 84
 date well completed

LAYNE-CENTRAL CO.
 firm name

SUN FLOWER
 county well located

LANDOWNER:	description of formations encountered	from	to
SUNFLOWER ENTERPRISES	clay	0	20
DODDSVILLE, MS	sand	20	40
(mailing address)	coarse sand/gravel	40	113
WELL LOCATION: #4 of 4	fine sand	113	117
sec. 27 T 21 (N) R 4 E	CODED		
Mound pl.			
10 miles sw of Doddsville			
(distance) (direction) (nearest town)			
WELL PURPOSE: irrigation (home, irrigation, municipal, industrial)			
WELL COMPLETION DATA:			
(1) diameter (inches) 28"			
(2) total depth (feet) 110'			
(3) static water level (feet) 32' below top of ground.			
(4) casing steel 70 (material) (depth) 12" (size) if telescope see back.			
(5) screen 40' 70' (length) (depth to top)			
(6) pump 40 700 (HP) (yield gpm) gear drive (type power)			
(7) electric log no (yes or no)			
(organization running log)			
(8) how well bottom plugged st. plate			
DRILLERS REMARKS:			


DEPT. OF NATURAL RESOURCES
 BUREAU OF LAND & WATER RESOURCES

OCT 29 1984

RECEIVED

If well telescopes please sketch and show depths.

GROUND LEVEL

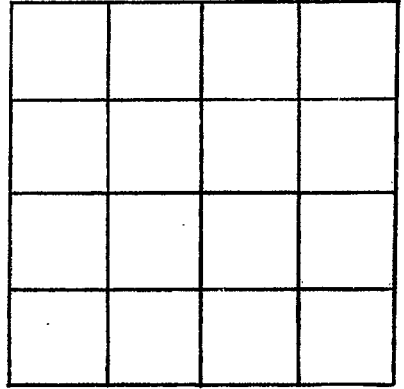

SECTION _____

Please indicate well location X.

ADDITIONAL INFORMATION

If more than one screen,
show locations of each on sketch.