

SUNFLOWER

CL-2607

G 86

MISSISSIPPI DEPARTMENT OF NATURAL RESOURCES

Bureau of Land and Water Resources

Southport Mall

P.O. Box 10631

Jackson, Mississippi 39209 CODED

WATER WELL DRILLERS LOG

3-22

19 84

LAYNE-CENTRAL CO.

SUNFLOWER

date well completed

firm name

county well located

LANDOWNER:

SUNFLOWER ENTERPRISES

DODDSDVILLE, MS

(mailing address)

description of formations encountered

from

to

clay

0

20

coarse sand

20

48

coarse sand/pea gravel

48

72

coarse sand/gravel

73

117

WELL LOCATION: #3 of 4

sec. 27 T21 N R 4 E

West Side Rd. Pl 5

10 miles sw of Doddsville (distance) (direction) (nearest town)

WELL PURPOSE: Irrigation

(home, irrigation, municipal, industrial)

WELL COMPLETION DATA:

CODED

- (1) diameter (inches) 28"
- (2) total depth (feet) 117'
- (3) static water level (feet) 33' below top of ground.
- (4) casing steel 77' (material) (depth) 12" (size) if telescope see back.
- (5) screen 40' 77' (length) (depth to top) 12" st. steel (size) (material)
- (6) pump 40 700 (HP) (yield gpm) gear drive (type power)
- (7) electric log no (yes or no) (organization running log) st. plate
- (8) how well bottom plugged

DEPT. OF NATURAL RESOURCES BUREAU OF LAND & WATER RESOURCES


OCT 29 1984

RECEIVED

DRILLERS REMARKS:

If well telescopes please sketch and show depths.

GROUND LEVEL

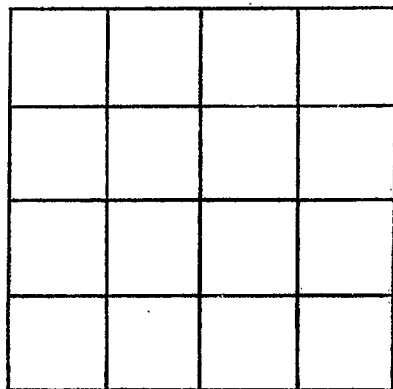

SECTION _____

Please indicate well location X.

ADDITIONAL INFORMATION

If more than one screen,
show locations of each on sketch.