

MISSISSIPPI DEPARTMENT OF NATURAL RESOURCES
Bureau of Land and Water Resources
 Southport Mall
 P.O. Box 10631
 Jackson, Mississippi 39209
WATER WELL DRILLERS LOG

CODED

<u>SUNFLOWER</u>
CL-2672
<u>688</u>

4-19 19 84 LAYNE-CENTRAL CO. SUNFLOWER
 date well completed firm name county well located

LANDOWNER:
 SUNFLOWER ENTERPRISES
 DODDSVILLE, MS
 (mailing address)

description of formations encountered	from	to
clay	0	15
coarse sand	15	35
coarse sand gravel	35	111
clay	111	

WELL LOCATION:
 sec 27 T 21 N R 4 E
 S W
 10 miles SW of DODDSVILLE
 (distance) (direction) (nearest town)

WELL PURPOSE: irrigation
 (home, irrigation, municipal, industrial)

WELL COMPLETION DATA:

- (1) diameter (inches) 32"
- (2) total depth (feet) 110'
- (3) static water level (feet) 33' below
 top of ground.
- (4) casing steel 60'
 (material) (depth)
16"
 (size) if telescope see back.
- (5) screen 50' 60'
 (length) (depth to top)
16" st. steel
 (size) (material)
- (6) pump 60 2500
 (HP) (yield gpm)
diesel
 (type power)
- (7) electric log n/a
 (yes or no)
(organization running log)
- (8) how well bottom plugged st. plate

DRILLERS REMARKS:

CODED


DEPT. OF NATURAL RESOURCES
 BUREAU OF LAND & WATER RESOURCES

OCT 29 1984

RECEIVED

If well telescopes please sketch and show depths.

GROUND LEVEL

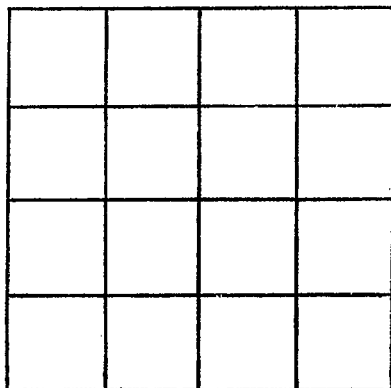

SECTION _____

Please indicate well location X.

ADDITIONAL INFORMATION

If more than one screen,
show locations of each on sketch.