

MISSISSIPPI DEPARTMENT OF NATURAL RESOURCES

Bureau of Land and Water Resources

Southport Mall

P.O. Box 10631

Jackson, Mississippi 39209

WATER WELL DRILLERS LOG

SUNFLOWER

G 89

Gw 6745

NE/SE, Sec. 5

Elev. 134

CODED

9-26-84

date well completed

1984

J+K Irrigation

firm name

Sunflower

county well located

LANDOWNER:

Tommy Lusk

Ridgeway, Miss.  
(mailing address)

description of formations encountered

from to

CLAY	0	65
FINE SAND	65	72
SAND GRAVEL	72	113

WELL LOCATION:

sec. 5 T. 21<sup>N</sup> R. 24<sup>E</sup>  
S W  
6 miles W of Ridgeway  
(distance) (direction) (nearest town)

WELL PURPOSE:

(home, irrigation, municipal, industrial)

WELL COMPLETION DATA:

- diameter (inches) 10
- total depth (feet) 113
- static water level (feet) 33 below/above top of ground.
- casing PVC 73  
(material) (depth)  
10 if telescope see back.  
(size)
- screen 40  
(length) (depth to top)  
10 PVC  
(size) (material)
- pump 10 600  
(HP) (yield gpm)  
electric  
(type power)
- electric log No  
(yes or no)

(organization running log)

(8) how well bottom plugged cap

DRILLERS REMARKS:


CODED

DEPT. OF NATURAL RESOURCES  
BUREAU OF LAND & WATER RESOURCES

OCT 16 1984  
RECEIVED

If well telescopes please sketch and show depths.

GROUND LEVEL

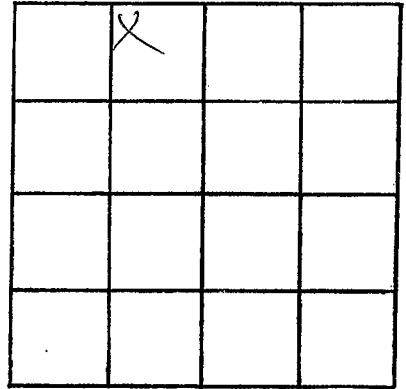

SECTION 5

Please indicate well location X.

ADDITIONAL INFORMATION

If more than one screen,  
show locations of each on sketch.