

SUNFLOWER

CL-2985 690

MISSISSIPPI DEPARTMENT OF NATURAL RESOURCES  
Bureau of Land and Water Resources  
Southport Mall  
P.O. Box 10631  
Jackson, Mississippi 39209  
WATER WELL DRILLERS LOG

CODED

5/10 19 85  
date well completed

LAYNE-CENTRAL CO.  
firm name

SUNFLOWER  
county well located

LANDOWNER:

SUNFLOWER ENTERPRISES

DODDSVILLE, MS

(mailing address)

description of formations encountered

clay

sand

coarse sand/gravel

from

to

0

15

15

35

35

122

WELL LOCATION:

sec. 27 T 21 N R 4 E  
3 W  
2 miles NW of Linn  
(distance) (direction) (nearest town)

CODED

WELL PURPOSE: irrigation  
(home, irrigation, municipal, industrial)

WELL COMPLETION DATA:

- (1) diameter (inches) 28"
- (2) total depth (feet) 122'
- (3) static water level (feet) 33' below above top of ground.
- (4) casing steel 82' (material) (depth)  
12" (size) if telescope see back.
- (5) screen 40' 82' (length) (depth to top)  
12" st. steel (size) (material)
- (6) pump 40 1200 (HP) (yield gpm)  
diesel (type power)
- (7) electric log no (yes or no)  
(organization running log) st. plate
- (8) how well bottom plugged

RECEIVED


JUL 9 1985

DRILLERS REMARKS:

Department of Natural Resources  
Bureau of Land & Water Resources

If well telescopes please sketch and show depths.

GROUND LEVEL

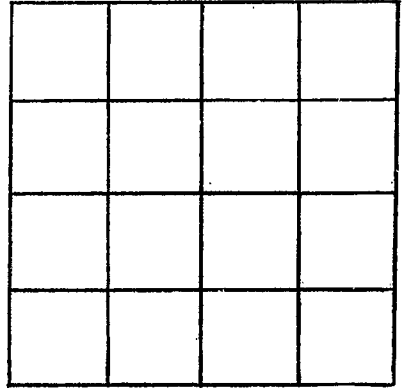

SECTION \_\_\_\_\_

Please indicate well location X.

ADDITIONAL INFORMATION

If more than one screen,  
show locations of each on sketch.