

MISSISSIPPI DEPARTMENT OF NATURAL RESOURCES

Bureau of Land and Water Resources

Southport Mall

P.O. Box 10631

Jackson, Mississippi 39209

WATER WELL DRILLERS LOG

TEP #  
87243-DCP-01  
Sunflower  
G 91

127 B  
Caled

8-31 1987 Dyer Well Sunflower  
date well completed firm name county well located

LANDOWNER: William L. Morgan

16 Aldersmead

Richmond VA 23236  
(mailing address)

description of formations encountered

from

to

Clay  
Sand & Gravel 0 40  
40 115

WELL LOCATION:

sec. 1 T 21 N R 4  
4 miles S Pulleville  
(distance) (direction) (nearest town)

WELL PURPOSE: Irrigation  
(home, irrigation, municipal, industrial)

WELL COMPLETION DATA:

- (1) diameter (inches) 16"
- (2) total depth (feet) 115'
- (3) static water level (feet) \_\_\_\_\_ below above top of ground.
- (4) casing steel (material), (depth) 16" (size) If telescope see back.
- (5) screen 40' (length), (depth to top) 16" (size), (material)
- (6) pump 60 (HP), (yield gpm) Electric (type power)
- (7) electric log No (yes or no) None (organization running log)
- (8) how well bottom plugged Plate

RECEIVED


OCT 30 1987

Department of Natural Resources  
Bureau of Land & Water Resources

DRILLERS REMARKS:

If well telescopes please sketch and show depths.

GROUND LEVEL

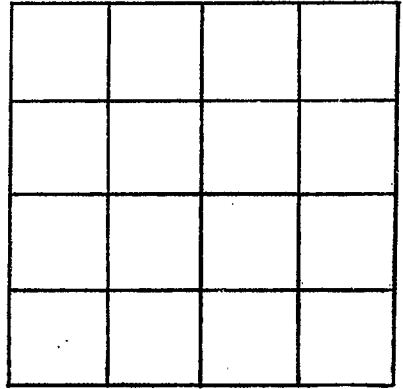

SECTION \_\_\_\_\_

Please indicate well location X.

ADDITIONAL INFORMATION

If more than one screen,  
show locations of each on sketch.