

MISSISSIPPI DEPARTMENT OF ENVIRONMENTAL QUALITY

Office of Land and Water Resources

P. O. Box 10631
Jackson, MS 39289-0631
WATER WELL DRILLERS LOG

COUNTY WELL LOCATED <u>Southwest</u>	
WELL NUMBER <u>G95</u>	CODED <input checked="" type="checkbox"/>
DATE WELL COMPLETED <u>9-28-93</u>	

PERMIT NUMBER
NAME OF DRILLING FIRM <u>CFS DRILLING</u>

NAME & MAILING ADDRESS OF LANDOWNER <u>Billy Maxwell</u> <u>Rt 1, Box 530</u> <u>Rollville, ms.</u>			
WELL LOCATION: SEC	TOWNSHIP	RANGE	
<u>36</u>	<u>T21 N</u>	<u>4</u>	<u>W</u>
DISTANCE	DIRECTION	NEAREST TOWN	
<u>2.5</u> Miles	<u>W</u>	of <u>Rollville</u>	
OTHER LANDMARK			
WELL PURPOSE: Home, Irrigation, Municipal, Industrial, Fish Pond, etc. <u>MINNOW FARM</u>			

PUMP DATA		
PUMP TYPE (Circle One): <u>Submersible</u> Turbine, Jet, Flowing Well, Other (Describe) _____		
POWER TYPE (Circle One): <u>Electric</u> Tractor, Diesel, Gasoline, Butane, Other (Describe) _____ H/P _____		
Pump Capacity (GPM) <u>75</u>	No. of Stages <u>11</u>	Setting Depth <u>126</u> FT.
PUMP TEST		
Well yielded <u>75</u> GPM with a drawdown of <u>49</u> ft. after <u>8</u> hours of pumping		

WELL DATA		
Well Depth <u>690</u>	Casing Diameter (In.) <u>4"</u>	Casing Length (Ft.) <u>660</u>
Type of Casing <u>Pvc</u>	Hole Depth <u>706</u>	Depth to Static Water Level <u>42</u>

LOG DATA	
TYPE OF LOG RUN (Circle One): Electric, Gamma Ray, Density, Sonic, Neutron, Other (Describe) _____	
Name of Organization Running Log	

TYPE OF COMPLETION: (Circle One or More): <u>Natural Development</u> , Underreamed, Telescoped, Open-Hole, Other	
WELL GROUTED TO A DEPTH OF <u>12</u> FEET Type Grout (circle one): <u>Cement</u> , Bentonite, or Mix	

GEOLOGIC DATA (Office Use Only)			
Surface Elev.	Geologic Unit	Unit Thickness	Depth to Top
Subs. SWL	Date	Analysis	Aquifer Test

SCREEN DATA		
Diameter - Inches <u>4"</u>	Length - Feet <u>30</u>	Slot Size - Inches <u>.010</u>
Screen Type <u>Pvc</u>	Depth to Bottom - Feet <u>690</u>	

Driller's Remarks

DESCRIPTION OF FORMATIONS ENCOUNTERED	FROM	TO	FORMATIONS (Continued)	FROM	TO
TOP SOIL	0	17			
SAW6	17	39			
SAND & GRAVEL	39	141			
SAND & ST. CLAY	141	202			
CLAY	202	241			
SANDY SHELL & BECKS	241	361			
SHELL	361	562			
SANDY SHELL	562	893			
SAUD	893	696			
CLAY	696	706			

RECEIVED


JAN 03 1994

Dept. of Environmental Quality
Office of Land & Water Resources

IF MORE SPACE IS NEEDED, USE BACK

If well telescopes please sketch and show depths.

GROUND LEVEL

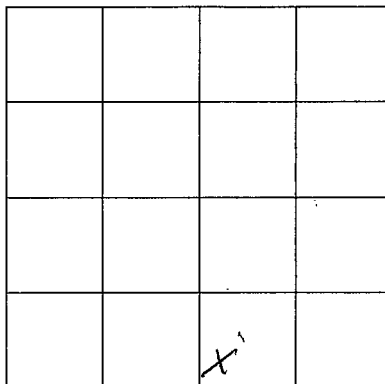

SECTION 36

Please indicate well location X.

ADDITIONAL INFORMATION

If more than one screen,
show location of each on sketch.