

MISSISSIPPI DEPARTMENT OF NATURAL RESOURCES

Bureau of Land and Water Resources

Southport Mall

P.O. Box 10631

Jackson, Mississippi 39209

CODED

Elev. 126 WATER WELL DRILLERS LOG

Sunflower
G 96
6-19-81

GW 5007
IR/IR, Sec. 2

6-19-81 19 Dyerwell Dring Sunflower
date well completed firm name county well located

LANDOWNER: Billy Maslow
Rt 1 Box 218
Ruleville Mo 38771
(mailing address)

| description of formations encountered | from | to |
|---------------------------------------|-----------|------------|
| <u>Clay</u> | <u>0</u> | <u>68</u> |
| <u>Fine sand</u> | <u>68</u> | <u>90</u> |
| <u>Sand & gravel</u> | <u>90</u> | <u>108</u> |

WELL LOCATION:
sec. 2 T. 21 N. R. 4 E.
2 miles W of Ruleville
(distance) (direction) (nearest town)

WELL PURPOSE:
(home, irrigation, municipal, industrial)

WELL COMPLETION DATA:

(1) diameter (inches) 16

(2) total depth (feet) _____

(3) static water level (feet) 24 below above top of ground.

(4) casing Steel (material), _____ (depth),
16 (size) if telescope see back.

(5) screen 40 (length), _____ (depth to top),
16 (size), _____ (material)

(6) pump 40 (HP), 200 (yield gpm)
diesel (type power)


(7) electric log NO (yes or no)

(organization running log)

(8) how well bottom plugged Plate


DRILLERS REMARKS:

CODED

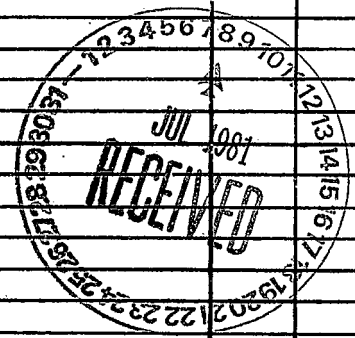

If well telescopes please sketch and show depths.

GROUND LEVEL

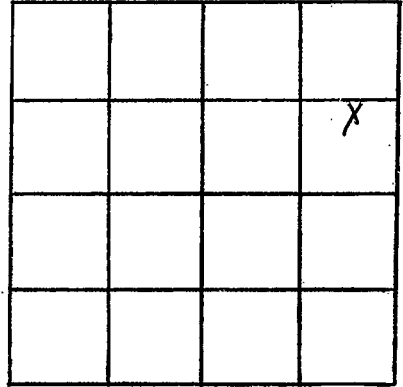

SECTION 2

Please indicate well location X.

ADDITIONAL INFORMATION

If more than one screen, show locations of each on sketch.